

MARSHALL  
66  
12-20-69

MISSISSIPPI  
BOARD OF WATER COMMISSIONERS  
416 North State Street  
Jackson, Mississippi 39201

**CODED**

WATER WELL DRILLERS LOG

Dec 20 19 69      Robert W. Wilson      Marshall  
date well completed      firm name      county well located

LANDOWNER: Thomas Rye  
RT #1  
Lamar, Miss  
(mailing address)

description of formations encountered	from	to
Red Clay & Red sand	0	20
Red sand	20	140
Red sand white clay	140	160
white clay white sand	160	180

WELL LOCATION:  
sec. 23 T-2 N S R-2 E W  
miles \_\_\_\_\_ of \_\_\_\_\_  
(distance) (direction) (nearest town)

WELL PURPOSE:  
(home, irrigation, municipal, industrial)

- WELL COMPLETION DATA:
- (1) diameter (inches) 4
  - (2) total depth (feet) 180
  - (3) static water level (feet) 140 below top of ground.
  - (4) casing Plastic, 176,  
(material) (depth)  
4 if telescope see back.  
(size)
  - (5) screen 4', 176  
(length) (depth to top)  
4", Gravel Pack  
(size) (material)
  - (6) pump 1/2, 70  
(HP) (yield gpm)  
Electric  
(type power)
  - (7) electric log yes  
(yes or no)  
✓  
(organization running log)
  - (8) how well bottom plugged 4"  
Plastic Cap

**CODED**


JAN 20 1970

DRILLERS REMARKS:

MISS. DE. OF  
WATER COMMISSIONERS

If well telescopes please sketch and show depths.

GROUND LEVEL

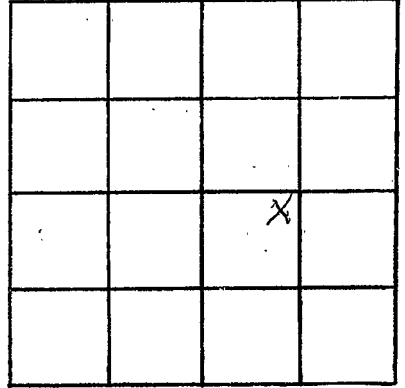

SECTION 23

Please indicate well location X.

ADDITIONAL INFORMATION

If more than one screen, show locations of each on sketch.