

Marshall
G 7

MISSISSIPPI
BOARD OF WATER COMMISSIONERS
416 North State Street
Jackson, Mississippi 39201

CODED

WATER WELL DRILLERS LOG

Atkinson & Frost Marshall

date well completed _____ firm name _____ county well located _____

LANDOWNER:
Wesley Ray
Holly Springs, Miss
(mailing address)

description of formations encountered	from	to
<u>CLAY</u>	<u>0</u>	<u>12</u>
<u>Red SAND</u>	<u>12</u>	<u>35</u>
<u>White CLAY</u>	<u>35</u>	<u>40</u>
<u>White SAND</u>	<u>40</u>	<u>175</u>

WELL LOCATION:
sec. 2 T 2 N R 2 E
6 miles NW of Hudsonville
(distance) (direction) (nearest town)

WELL PURPOSE:
(home, irrigation, municipal, industrial)

WELL COMPLETION DATA:

- (1) diameter (inches) 4"
- (2) total depth (feet) 175
- (3) static water level (feet) 135 below top of ground.
- (4) casing P.V.C. 175
(material) (depth)
(size) if telescope see back.
- (5) screen 10' 165
(length) (depth to top)
4" P.V.C.
(size) (material)
- (6) pump 1/4 10
(HP) (yield gpm)
elec.
(type power)
- (7) electric log _____
(yes or no)

(organization running log)
- (8) how well bottom plugged CAP.

CODED


APR 17 1971

MISS.

DRILLERS REMARKS:

If well telescopes please sketch and show depths.

GROUND LEVEL

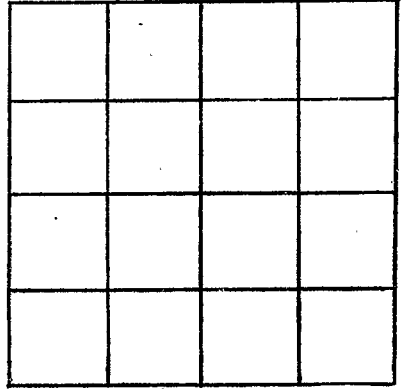

SECTION _____

Please indicate well location X.

ADDITIONAL INFORMATION

If more than one screen, show locations of each on sketch.