

Marshall  
G 8  
4-7-70

MISSISSIPPI  
BOARD OF WATER COMMISSIONERS  
416 North State Street  
Jackson, Mississippi 39201

**CODED**

WATER WELL DRILLERS LOG

4-7 1970 Robert W. Wilson Marshall  
date well completed firm name county well located

LANDOWNER: Bill Dillen  
Lamar  
Miss  
(mailing address)

description of formations encountered	from	to
Red Clay red sand	0	20
Red sand	20	120
Red sand white clay white sand	120	140
white sand	140	170

WELL LOCATION:  
sec. 2 T 2 N R 2 E  
(distance) (direction) (nearest town)

WELL PURPOSE: Home  
(home, irrigation, municipal, industrial)

WELL COMPLETION DATA:

- (1) diameter (inches) 4
- (2) total depth (feet) 170
- (3) static water level (feet) 140 below top of ground.
- (4) casing Plastic 166 (material) (depth)  
4 (size) if telescope see back.
- (5) screen 4 (length) 166 (depth to top)  
4 Plastic (size) (material)
- (6) pump 1 (HP) 18 (yield gpm)  
Electric (type power)
- (7) electric log (yes or no)
- (organization running log)
- (8) how well bottom plugged 4  
Plastic Cap

**CODED**


APR 22 1970

MISS. BD. OF WATER COMMISSIONERS

DRILLERS REMARKS:

If well telescopes please sketch and show depths.

GROUND LEVEL

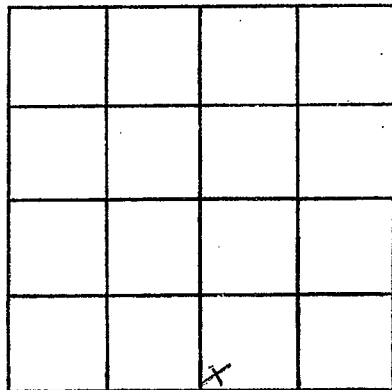

SECTION 23

Please indicate well location X.

ADDITIONAL INFORMATION

If more than one screen, show locations of each on sketch.