

**Marshall**  
**G9**  
**5-5-70**

MISSISSIPPI  
 BOARD OF WATER COMMISSIONERS  
 416 North State Street  
 Jackson, Mississippi 39201

**CODED**  
**CODED**

**WATER WELL DRILLERS LOG**

5-5-70 date well completed  
 1970 Thoape Wells Supply Co. firm name  
 Marshall county well located

LANDOWNER Lewis H. Bryson  
RT #1 Box 38B  
Lamar, Mississippi  
 (mailing address)

description of formations encountered	from	to
Brown Sand	0	40
White med Sand	40	60
" " " + clay	60	75
white coarse sand	75	110
white med. sand + clay	110	125
white coarse sand	125	143

WELL LOCATION:  
 sec. 14 T. 2 S. R. 2 E. 156  
4 miles SE of Snyder  
 (distance) (direction) (nearest town)

WELL PURPOSE:  
 (home, irrigation, municipal, industrial)

- WELL COMPLETION DATA:
- (1) diameter (inches) 4"
  - (2) total depth (feet) 146
  - (3) static water level (feet) 60 <sup>below</sup> <sub>above</sub> top of ground.
  - (4) casing PVC (NSF), 142'  
 (material) (depth)  
 (size) if telescope see back.
  - (5) screen 4', 142'  
 (length) (depth to top)  
4" PVC Filter Pack  
 (size) (material)
  - (6) pump 1/2 (HP) (yield gpm)  
220 SP  
 (type power)
  - (7) electric log No  
 (yes or no)

**CODED**

JUN 1 - 1970


(organization running log)

(8) how well bottom plugged end of screens 4" cap

DRILLERS REMARKS:

If well telescopes please sketch and show depths.

GROUND LEVEL

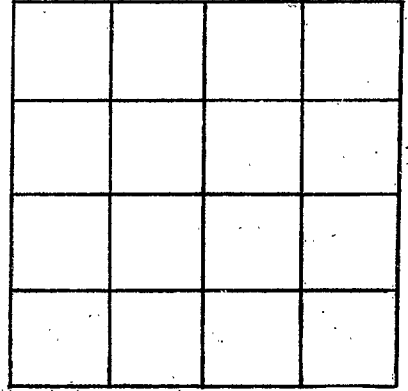

SECTION \_\_\_\_\_

Please indicate well location X.

ADDITIONAL INFORMATION

If more than one screen, show locations of each on sketch.