

MARSHALL
G 10
7-7-70

MISSISSIPPI
BOARD OF WATER COMMISSIONERS
416 North State Street
Jackson, Mississippi 39201

CODED

WATER WELL DRILLERS LOG

July 7 1970 Bumpas Well Co. Holly Springs Miss
date well completed firm name county well located
Marshall Co.

LANDOWNER:
Rowdy Brown
Lamar, Miss
(mailing address)

description of formations encountered	from	to
	<u>clay</u>	<u>0</u>
<u>Sand</u>	<u>20</u>	<u>30</u>
<u>clay</u>	<u>30</u>	<u>40</u>
<u>Sand</u>	<u>40</u>	<u>160</u>

WELL LOCATION:
sec. 13 T 2 N R 20 E
5 miles West of Lamar
(distance) (direction) (nearest town)

WELL PURPOSE: Sweetening
(home, irrigation, municipal, industrial)

WELL COMPLETION DATA: 11

- (1) diameter (inches) 11
- (2) total depth (feet) 160 feet
- (3) static water level (feet) 140 below above top of ground.
- (4) casing PVC 160 feet
(material) (depth)
(size) If telescope see back.
- (5) screen 6 ft 15 feet
(length) (depth to top)
4" gravel wall
(size) (material)
- (6) pump 3/4 10
(HP) (yield gpm)
(type power)
- (7) electric log Yes
(yes or no)
(organization running log)
- (8) how well bottom plugged 4" cap

CODED


OCT 19 1970

MISS. BD. OF
WATER COMM.

DRILLERS REMARKS:

If well telescopes please sketch and show depths.

GROUND LEVEL

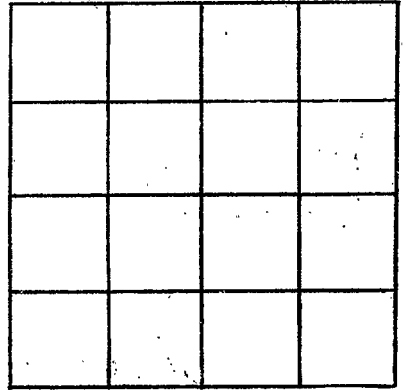

SECTION _____

Please indicate well location X.

ADDITIONAL INFORMATION

If more than one screen, show locations of each on sketch.