

MARSHALL

G 11

10-14-70

MISSISSIPPI BOARD OF WATER COMMISSIONERS
416 North State Street
Jackson, Mississippi 39201

CODED

WATER WELL DRILLERS LOG

Oct. 14 1970 R. L. Carpenter Marshall
date well completed firm name county well located

LANDOWNER: William Shelton
Lamar, Miss.

R.F.O.
(mailing address)

WELL LOCATION:

sec 14 T 2 N R 2 E
5 miles southwest of Slayton
(distance) (direction) (nearest town)

WELL PURPOSE: Home
(home, irrigation, municipal, industrial)

WELL COMPLETION DATA:

- (1) diameter (inches) 4 in
- (2) total depth (feet) 175
- (3) static water level (feet) 120 below above top of ground.
- (4) casing Plastic, 169 ft
(material) (depth)
- If telescope see back.
(size)
- (5) screen 6 ft, 169 ft
(length) (depth to top)
- 4 in, Plastic & Sand
(size) (material)
- (6) pump 3/4 10
(HP) (yield gpm)
- 2 hp.
(type power)
- (7) electric log no
(yes or no)

(organization running log)
Plastic Plog

(8) how well bottom plugged

description of formations encountered	from	to
<u>Surface Soil</u>	<u>0</u>	<u>12</u>
<u>Med Red Sand</u>	<u>12</u>	<u>40</u>
<u>Med white sand</u>	<u>40</u>	<u>83</u>
<u>Coarse white sand</u>	<u>83</u>	<u>128</u>
<u>white clay</u>	<u>128</u>	<u>140</u>
<u>white Coarse sand</u>	<u>140</u>	<u>175</u>

CODED


DEC 7 1970

MISS. BD. OF WATER COMM.

DRILLERS REMARKS:

If well telescopes please sketch and show depths.

GROUND LEVEL

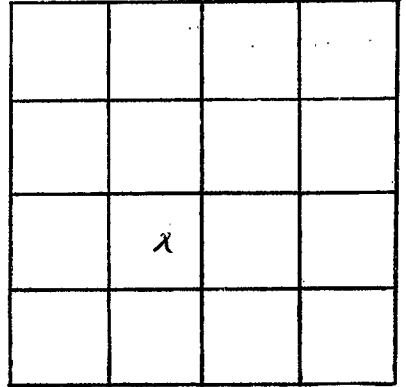

SECTION 14

Please indicate well location X.

ADDITIONAL INFORMATION

If more than one screen, show locations of each on sketch.