

MARSHALL

G12

11-2-70

MISSISSIPPI
 BOARD OF WATER COMMISSIONERS
 416 North State Street
 Jackson, Mississippi 39201

CODED

WATER WELL DRILLERS LOG

Nov. 2 1970
date well completed

R. L. Capester
firm name

Marshall
county well located

LANDOWNER: Louis Valentine

Moscow, Tenn.

RFD

(mailing address)

WELL LOCATION:

sec. 15 T 2 N R 2 E
 3 1/2 miles Southeast of Glasgow
 (distance) (direction) (nearest town)

WELL PURPOSE: Farm
 (home, irrigation, municipal, industrial)

WELL COMPLETION DATA:

- (1) diameter (inches) 4 in.
- (2) total depth (feet) 197
- (3) static water level (feet) 106 below above top of ground.
- (4) casing Plastic, 185 ft (material) (depth)
 (size) If telescope see back.
- (5) screen 12 ft., 185 ft. (length) (depth to top)
 4 in. Plastic & Havel (size) (material)
- (6) pump 1 1/2 (HP) 20 (yield gpm)
 Elec. (type power)
- (7) electric log no (yes or no)

(organization running log)

(8) how well bottom plugged Plastic Plug

description of formations encountered

from to

Surface Soil	0	18
Med. Red Sand	18	50
Med. white sand	50	92
white clay	92	110
Coarse white sand	110	138
white fine sand	138	160
white coarse sand	160	197

CODED


DEC 7 1970

DRILLERS REMARKS:

MISC. DD. OF
WATER COMM.

If well telescopes please sketch and show depths.

GROUND LEVEL

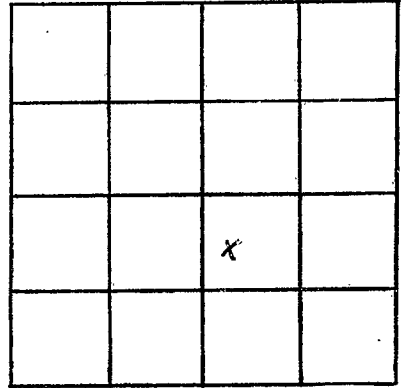

SECTION 15

Please indicate well location X.

ADDITIONAL INFORMATION

If more than one screen, show locations of each on sketch.