

MARSHALL
G 14
4-27-71

MISSISSIPPI
 BOARD OF WATER COMMISSIONERS
 416 North State Street
 Jackson, Mississippi 39201

CODED

WATER WELL DRILLERS LOG

4-27-71 Robert W. Wilson Marshall
 date well completed firm name county well located

LANDOWNER: Luther M. Hester
Holly Springs
MISS
 (mailing address)

description of formations encountered	from	to
<u>Red Clay bedded</u>	<u>0</u>	<u>20</u>
<u>Red sand</u>	<u>20</u>	<u>80</u>
<u>Red sand white clay</u>	<u>80</u>	<u>100</u>
<u>White sand</u>	<u>100</u>	<u>140</u>

WELL LOCATION:
 sec. 26 T. 2 N. R. 2 E.
 (S) (W)
 miles of
 (distance) (direction) (nearest town)

WELL PURPOSE:
 (home, irrigation, municipal, industrial)

- WELL COMPLETION DATA:
- (1) diameter (inches) 4
 - (2) total depth (feet) 140
 - (3) static water level (feet) 115 below top of ground.
 - (4) casing Plastic, 136,
 (material) (depth)
4 if telescope see back.
 (size)
 - (5) screen 4, 136
 (length) (depth to top)
4, Armed Mesh
 (size) (material)
 - (6) pump 3/4, 10
 (HP) (yield gpm)
Electric
 (type power)
 - (7) electric log ✓
 (yes or no)

CODED

(organization running log)

(8) how well bottom plugged 4"
Plastic Cap


JUN 2 1971

DRILLERS REMARKS:

MISS. BD. OF
 WATER COMMISSIONERS

If well telescopes please sketch and show depths.

GROUND LEVEL

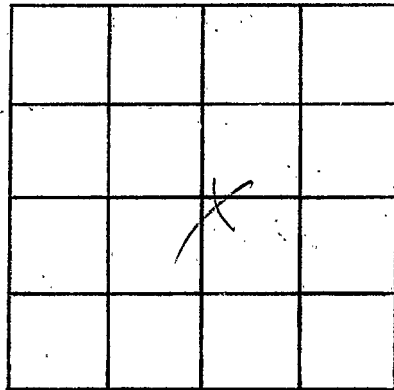

SECTION 26

Please indicate well location X.

ADDITIONAL INFORMATION

If more than one screen,
show locations of each on sketch.