

MARSHALL
G15
5-7-71

MISSISSIPPI
 BOARD OF WATER COMMISSIONERS
 416 North State Street
 Jackson, Mississippi 39201

CODED

WATER WELL DRILLERS LOG

May 7 1971 date well completed
 Earl Jones Well Co. firm name
 Marshall county well located

LANDOWNER:
 Atwood Jones
 Samson Miss. RT.
 (mailing address)

description of formations encountered	depth	
	from	to
Topsoil + clay	0	15
sand	15	85
clay	85	90
sand	90	166

WELL LOCATION:
 sec 15 T 2 N R 2 E
 5 miles SE of Slayden
 (distance) (direction) (nearest town)

WELL PURPOSE: Home
 (home, irrigation, municipal, industrial)

- WELL COMPLETION DATA:
- (1) diameter (inches) 2"
 - (2) total depth (feet) 166'
 - (3) static water level (feet) 114' below top of ground.
 - (4) casing Plastic 160' (material), (depth)
 2" (size) if telescope see back.
 - (5) screen 6' 160' (length), (depth to top)
 2" (size), Plastic gravel (material)
 - (6) pump 1 3 1/2 (HP), (yield gpm)
 Electric (type power)
 - (7) electric log no. (yes or no)

CODED

(organization running log)

JUN 2 1971


(8) how well bottom plugged
 Plastic cap

MISS. Bd. OF
 WATER COMM.

DRILLERS REMARKS:

If well telescopes please sketch and show depths.

GROUND LEVEL

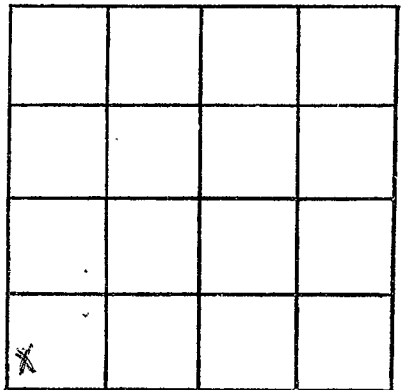

SECTION _____

Please indicate well location X.

ADDITIONAL INFORMATION

If more than one screen,
show locations of each on sketch.