

MARSHALL
G 16
5-11-71

MISSISSIPPI
 BOARD OF WATER COMMISSIONERS,
 416 North State Street
 Jackson, Mississippi 39201

CODED

WATER WELL DRILLERS LOG

May 11, 1971 Earl Jones Well Co. Marshall
 date well completed firm name county well located

LANDOWNER:
Earl Jones
Samson Miss. RT.
 (mailing address)

description of formations encountered	from	to
	<u>Topsoil & clay sand</u>	<u>0</u>
<u>clay</u>	<u>18</u>	<u>90</u>
<u>sand</u>	<u>90</u>	<u>92</u>
	<u>92</u>	<u>146</u>

WELL LOCATION:
 sec 10 T 2 N 2 R 2 E
4 miles S.E. of Slayden
 (distance) (direction) (nearest town)

WELL PURPOSE: Home
 (home, irrigation, municipal, industrial)

- WELL COMPLETION DATA:
- (1) diameter (inches) 2"
 - (2) total depth (feet) 146'
 - (3) static water level (feet) 80' below above top of ground.
 - (4) casing 2" plastic
 (material) (depth)
2"
 (size) if telescope see back.
 - (5) screen 6' 140'
 (length) (depth to top)
2" plastic gravel
 (size) (material)
 - (6) pump 1 5
 (HP) (yield gpm)
Electric
 (type power)
 - (7) electric log no
 (yes or no)

CODED

(organization running log)

(8) how well bottom plugged
plastic cap


JUN 2 1971

DRILLERS REMARKS:

MISS. BD. OF
 WATER COMM.

If well telescopes please sketch and show depths.

GROUND LEVEL

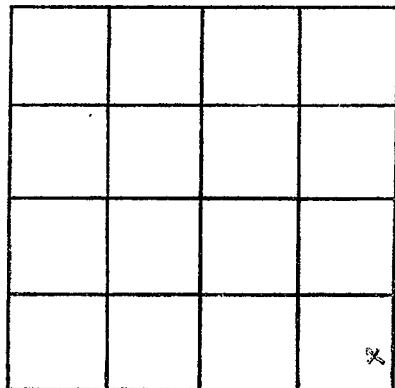

SECTION 10

Please indicate well location X.

ADDITIONAL INFORMATION

If more than one screen, show locations of each on sketch.