

Marshall
G 17
9-6-71

MISSISSIPPI
 BOARD OF WATER COMMISSIONERS
 416 North State Street
 Jackson, Mississippi 39201

WATER WELL DRILLERS LOG

Sept 6 1971 Earl Jones Well Co. Marshall
 date well completed firm name located

CODED

LANDOWNER:


Marshall Jones
Lamar Miss. RT.
 (mailing address)

description of formations encountered

from to

<u>Top Soil & clay</u>	<u>0</u>	<u>16</u>
<u>sand</u>	<u>16</u>	<u>105</u>
<u>clay</u>	<u>105</u>	<u>110</u>
<u>sand</u>	<u>110</u>	<u>150</u>
<u>clay</u>	<u>150</u>	<u>190</u>
<u>sand</u>	<u>190</u>	<u>206</u>

WELL LOCATION:

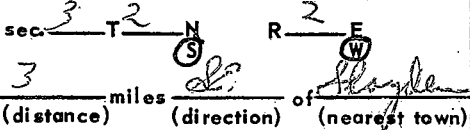

WELL PURPOSE: Home
 (home, irrigation, municipal, industrial)

WELL COMPLETION DATA:

- (1) diameter (inches) 2"
 - (2) total depth (feet) 206
 - (3) static water level (feet) 110 below above top of ground.
 - (4) casing plastic 200 ft.
 (material) (depth)
2"
 (size) if telescope see back.
 - (5) screen 6" 200
 (length) (depth to top)
2" plastic filter pack
 (size) (material)
 - (6) pump 1 1/2 4 1/2
 (HP) (yield gpm)
Electric
 (type power)
 - (7) electric log no
 (yes or no)
- (organization running log)
- (8) how well bottom plugged plastic cap


CODED

DRILLERS REMARKS:

OCT 6 - 1971

If well telescopes please sketch and show depths.

GROUND LEVEL

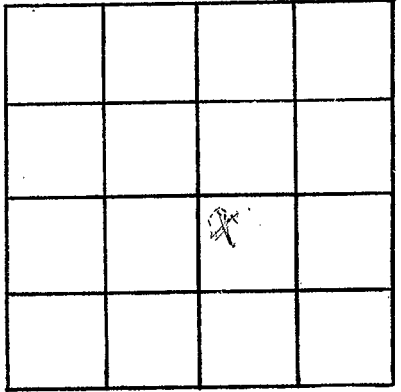

SECTION 201

Please indicate well location X.

ADDITIONAL INFORMATION

If more than one screen, show locations of each on sketch.