

Marshall
G18
8-66

WATER WELL DRILLERS LOG

Date: Aug. 24, 1966, Driller: Larry Carpenter County Marshall
(Name)

(1) Owner of Land:	Description & Color of Materials Sand, Clay, Red Clay, Shell, etc.	Thick- ness Feet	Depth Feet
<u>Boyce Crawford</u> (Name) <u>Slayden, Miss.</u> (Address)	<u>Surface Soil to</u>	<u>8</u>	<u>8</u>
(2) Location: <u>1/4, 1/4, Sec 6 2524</u>	<u>Red fine sand</u>		
<u>1</u> miles <u>West</u> , of <u>Slayden</u> (distance) (direction) (Nearest Town)	<u>from 8 to 28 ft.</u>	<u>20</u>	<u>28</u>
(3) Topography: <u>Hilly</u> (Hilly) (Flat) (Level)	<u>Sand rock from</u>		
(4) Purpose of Well: <u>Resident</u> (Domestic Irrigation Municipal, Industrial, Other)	<u>28 to 29 ft.</u>	<u>1</u>	<u>29</u>
	<u>White clay</u>		
	<u>from 29 to 35 ft.</u>	<u>6</u>	<u>35</u>


Information upon completion of well:

- (1) Diameter 4 inches.
- (2) Total Depth 150 feet.
- (3) Water Level 120 feet below top of ground.
- (4) Cased to 143, Size 4"
- (5) Screen: Size 4, Length 7 ft.
- (6) Were any formations sealed against pollution?
yes, no.

<u>White coarse</u>		
<u>sand from 35</u>	<u>36</u>	<u>76</u>
<u>to 71 ft.</u>		
<u>Red and white</u>		
<u>coarse sand</u>		
<u>mixed from</u>		
<u>71 to 80 ft.</u>	<u>9</u>	<u>80</u>
<u>White coarse</u>		
<u>sand from</u>		
<u>80 ft. to 150 ft.</u>	<u>70</u>	<u>150</u>

If YES depth of formation _____
Why _____

Drillers Remarks: _____

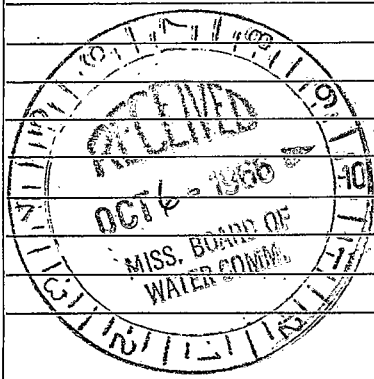

(Use Back Side)

Well No.

1870
1871
1872
1900