

Marshall

G19

10-66

MISSISSIPPI BOARD OF WATER COMMISSIONERS

WATER WELL DRILLERS LOG

Date: Oct. 20, 1966, Driller: Larry Carpenter County, Marshall

(When well drilled)

(Name)

(Where well is located)

(1) Owner of Land: Robert Reed

(Name)

Lamar, Miss.

(Address)

(2) Location: SW 1/4, NE 1/4, Sec. 23 T25R2W

3 miles North of Hudsonville, Miss.

(distance)

(direction)

(Nearest Town)

(3) Topography: Hilly

(Hilly)

(lat)

(Level)

(4) Purpose of Well: Resident

(Domestic Irrigation, Municipal, Industrial, Other)

Information upon completion of well:

(1) Diameter 4 inches.

(2) Total Depth 245 feet.

(3) Water Level 182 feet below top of ground.

(4) Cased to 238, Size 4 in.

(5) Screen: Size 4 in., Length 7 ft.

(6) Were any formations sealed against pollution? yes, X no.

If YES depth of formation

Why


Drillers Remarks:

Yield in gpm: Seven

Size pump: 1/2 HP - Submersible Pump

Type power: 220 volt. Etc.

Description & Color of Materials Sand, Clay, Red Clay, Shell, etc.	Thick- ness Feet	Depth Feet
Surface Soil	16	16
Med. Red Sand	12	28
Coarse Red Sand	24	52
Coarse White Sand	38	90
White Clay	2	92
White Coarse sand	28	120
Fine Sand mixed		
White Clay	2	122
White Coarse sand	57	179
Fine Sand mixed		
White Fine Sand	36	215
Med. and Fine	11	226
White sand mixed		
White Coarse Sand	19	245

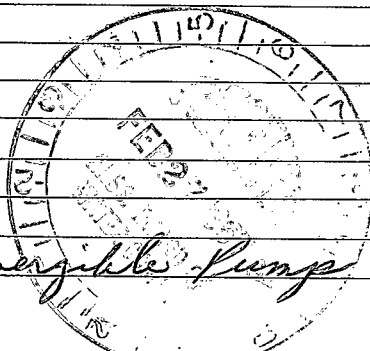

Mail this copy to Board of Water Commissioners 429 Miss. St. Jackson, Miss.

