

Marshall  
 G 20  
 10-66

MISSISSIPPI  
 BOARD OF WATER COMMISSIONERS  
 416 North State Street  
 Jackson, Mississippi 39201

WATER WELL DRILLERS LOG

10-25-1966 Robert W. Wilson Marshall  
 date well completed firm name county well located

LANDOWNER: Gunster Anderson  
 Lamar  
 Miss.  
 (mailing address)


description of formations encountered	from	to
Red Clay & Sand	0	10
Red Sand	10	110
White clay & White sand	110	150
White Sand	150	170

WELL LOCATION:  
 sec. 2 T 2 N R 2 E  
 1 miles 5 of Carpenter  
 (distance) (direction) (nearest town)

WELL PURPOSE: home  
 (home, irrigation, municipal, industrial)


- WELL COMPLETION DATA:
- (1) diameter (inches) 4"
  - (2) total depth (feet) 170'
  - (3) static water level (feet) 145' below top of ground.
  - (4) casing Plastic 166' (material) (depth)  
 4" (size) If telescope see back.
  - (5) screen 4' 166' (length) (depth to top)  
 2090 (size) (material)  
 4" Gal. Pac Slotted Pipe
  - (6) pump 3/4 (HP) (yield gpm)  
 Elect. (type power)
  - (7) electric log NO (yes or no)  
 (organization running log)
  - (8) how well bottom plugged 4"  
 Plastic Cap

DRILLERS REMARKS:

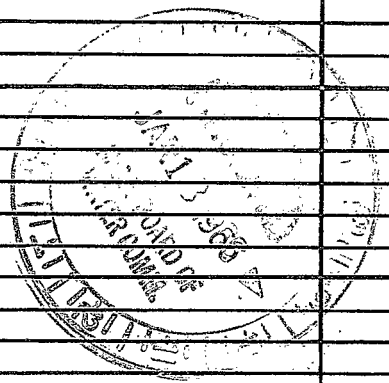

If well telescopes please sketch and show depths.

GROUND LEVEL

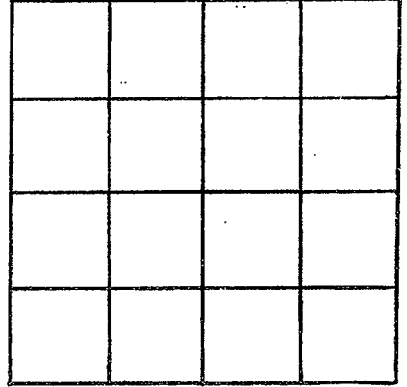

SECTION \_\_\_\_\_

Please indicate well location X.

ADDITIONAL INFORMATION

If more than one screen,  
show locations of each on sketch.