

Marshall

G 21

3-67

MISSISSIPPI  
BOARD OF WATER COMMISSIONERS  
416 North State Street  
Jackson, Mississippi 39201

WATER WELL DRILLERS LOG

3-16 1967 Robert Wilson Marshall  
date well completed firm name county well located

LANDOWNER:

Luther Mathis

(mailing address)

description of formations  
encountered

from

to

Red Clay & Sand  
Red Sand  
White Sand

0 20  
20 160  
160 222

WELL LOCATION:

sec. 24 T. 2 N. R. 2 E.  
2 miles S. of Samar  
(distance) (direction) (nearest town)

WELL PURPOSE:

(home, irrigation, municipal, industrial)

WELL COMPLETION DATA:

(1) diameter (inches) 4"  
(2) total depth (feet) 220'  
(3) static water level (feet) 160' below  
top of ground.

(4) casing Plastic, 200'  
(material) (depth)

4" If telescope see back.  
(size)

(5) screen 20' , 200'  
(length) (depth to top)

4 , Gravel Pack  
(size) (material)

(6) pump 3/4 18  
(HP) (yield gpm)


Elect.  
(type power)

(7) electric log (yes or no)

(organization running log)

(8) how well bottom plugged 4"  
Plastic Cap

DRILLERS REMARKS:

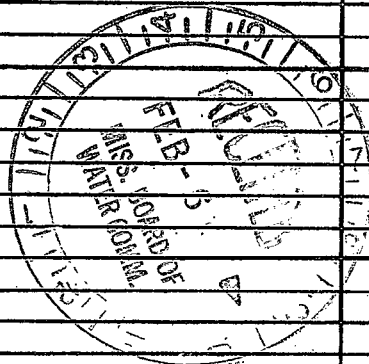

If well telescopes please  
sketch and show depths.

GROUND LEVEL

		X	

SECTION 24

Please indicate well location X.

ADDITIONAL INFORMATION

If more than one screen,  
show locations of each on sketch.