

Marshall  
 G 22  
 6-67

MISSISSIPPI  
 BOARD OF WATER COMMISSIONERS  
 416 North State Street  
 Jackson, Mississippi 39201

WATER WELL DRILLERS LOG

June 7 19 67 R. L. Carpenter Marshall  
 date well completed firm name county well located

LANDOWNER: S. J. Nicholson Estate  
 Snyder,  
 Miss.  
 (mailing address)

WELL LOCATION:  
 sec. 6 T 2 N R 2 E  
 S W  
 4 miles East of Mt. Pleasant  
 (distance) (direction) (nearest town)


WELL PURPOSE: Home  
 (home, irrigation, municipal, industrial)

WELL COMPLETION DATA:

- (1) diameter (inches) 4 in.
- (2) total depth (feet) 185
- (3) static water level (feet) 175 below top of ground.
- (4) casing Plastic, 179, (material) (depth)  
 (size) if telescope see back.
- (5) screen 6 ft, 179 (length) (depth to top)  
 4 in, Plastic & Dravel (size) (material)
- (6) pump 3/4 (HP) (yield gpm)  
 Elec. (type power)
- (7) electric log No. (yes or no)  
 (organization running log)
- (8) how well bottom plugged Plastic Plug

| description of formations encountered | from | to  |
|---------------------------------------|------|-----|
| Surface Soil                          | 0    | 16  |
| Medium Red Sand                       | 16   | 40  |
| White Clay                            | 40   | 46  |
| White Fine Sand                       | 46   | 51  |
| White Coarse Sand                     | 51   | 185 |

DRILLERS REMARKS:

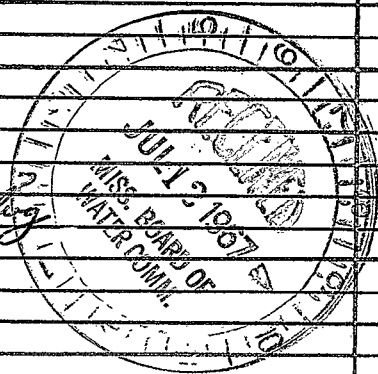

If well telescopes please sketch and show depths.

GROUND LEVEL

*R 2 w*

|          |  |  |  |
|----------|--|--|--|
| <i>x</i> |  |  |  |
|          |  |  |  |
|          |  |  |  |
|          |  |  |  |

*f25*

SECTION 6

Please indicate well location X.

ADDITIONAL INFORMATION

If more than one screen, show locations of each on sketch.