

Marshall  
 G23  
 6-67

MISSISSIPPI  
 BOARD OF WATER COMMISSIONERS  
 416 North State Street  
 Jackson, Mississippi 39201

WATER WELL DRILLERS LOG

June 20 19 67 R. L. Carpenter Marshall  
 date well completed firm name county well located

LANDOWNER: Gatewood Church

description of formations encountered from to

Lamar, RFD  
Miss.  
 (mailing address)

Surface soil 0 17

WELL LOCATION:  
 sec. 20 T. 2 N. R. 2 E.  
S W  
3 miles South of Slayden  
 (distance) (direction) (nearest town)

Medium Red sand 17 25

WELL PURPOSE: Church  
 (home, irrigation, municipal, industrial)

Medium white sand and white Clay mixed. 25 60

WELL COMPLETION DATA:

Medium white sand 60 80

- (1) diameter (inches) 4 in.
- (2) total depth (feet) 200 ft.
- (3) static water level (feet) 174 below above top of ground.
- (4) casing Plastic, 194,  
 (material) (depth)

White Clay 80 91

\_\_\_\_\_ if telescope see back.  
 (size)

Coarse white sand 91 200

- (5) screen 6 ft., 194  
 (length) (depth to top)  
4 in., Plastic & Shovel  
 (size) (material)

- (6) pump 3/4, 10  
 (HP) (yield gpm)


Elec.  
 (type power)

- (7) electric log No  
 (yes or no)

\_\_\_\_\_ (organization running log)

- (8) how well bottom plugged Plastic Plug

DRILLERS REMARKS:

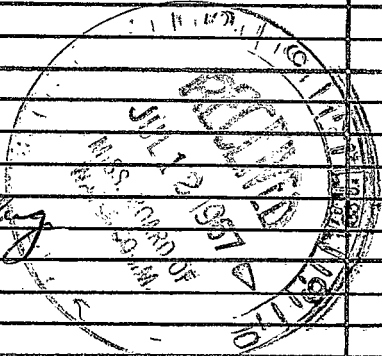


If well telescopes please sketch and show depths.

GROUND LEVEL

R2W

f25

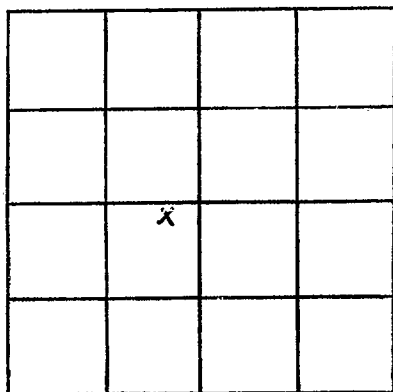

SECTION 20

Please indicate well location X.

ADDITIONAL INFORMATION

If more than one screen, show locations of each on sketch.