

Marshall  
 G25  
 J-67

MISSISSIPPI  
 BOARD OF WATER COMMISSIONERS  
 416 North State Street  
 Jackson, Mississippi 39201

WATER WELL DRILLERS LOG

Aug. 31 1967 R. L. Carpenter Marshall  
 date well completed firm name county well located


LANDOWNER: William Shelton  
 Lamar, RFD  
 Triss  
 (mailing address)

WELL LOCATION:  
 sec. 14 T. 2 N. R. 2 E  
 S. W.  
 3 1/2 miles Northeast of Okey  
 (distance) (direction) (nearest town)

WELL PURPOSE: None  
 (home, irrigation, municipal, industrial)

- WELL COMPLETION DATA:
- (1) diameter (inches) 4 in.
  - (2) total depth (feet) 200
  - (3) static water level (feet) 170 below top of ground.
  - (4) casing Plastic, 194, (material) (depth)  
 If telescope see back.  
 (size)
  - (5) screen 6 ft., 194 (length) (depth to top)  
 4 in., Plastic & Travel (size) (material)
  - (6) pump 3/4 10 (HP) (yield gpm)  
 Elec. (type power)
  - (7) electric log No (yes or no)  
 (organization running log)
  - (8) how well bottom plugged Plastic Plug

description of formations encountered	from	to
Surface soil	0	17
Med. Red sand	17	30
Red coarse sand	30	52
Coarse white sand	52	106
White clay	106	114
White fine sand	114	163
White clay	163	184
White coarse sand	184	200

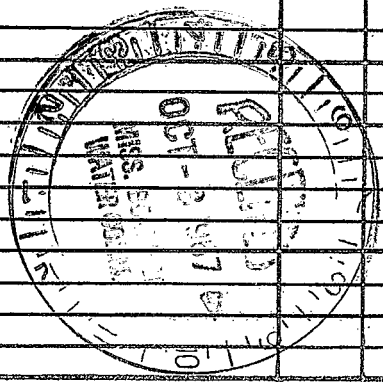


DRILLERS REMARKS:

If well telescopes please sketch and show depths.

GROUND LEVEL

R 2 W

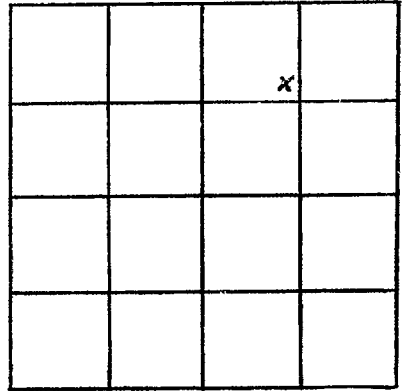

725

SECTION 14

Please indicate well location X.

ADDITIONAL INFORMATION

If more than one screen, show locations of each on sketch.