

MARSHALL

G 26

11-67

MISSISSIPPI
 BOARD OF WATER COMMISSIONERS
 416 North State Street
 Jackson, Mississippi 39201

WATER WELL DRILLERS LOG

Nov. 17, 1967 R. L. Carpenter Marshall
 date well completed firm name county well located

LANDOWNER: Elen Sharp
Lamar, Miss.

description of formations encountered	from	to
<u>surface soil</u>	<u>0</u>	<u>10</u>
<u>med. R.L. sand</u>	<u>10</u>	<u>31</u>
<u>white coarse sand</u>	<u>31</u>	<u>90</u>
<u>white clay</u>	<u>90</u>	<u>126</u>
<u>white coarse sand</u>	<u>126</u>	<u>167</u>


(mailing address)

WELL LOCATION:
 sec. 2 T. 2 N. R. 2 E.
 3 1/2 miles East of Slough
 (distance) (direction) (nearest town)

WELL PURPOSE: Home
 (home, irrigation, municipal, industrial)

WELL COMPLETION DATA:

- (1) diameter (inches) 4
- (2) total depth (feet) 167
- (3) static water level (feet) 95 below top of ground.
- (4) casing Plastic, 161,
 (material) (depth)
if telescope see back.
 (size)
- (5) screen 6ft., 161
 (length) (depth to top)
4in. Plastic Guard
 (size) (material)
- (6) pump 3/4 12
 (HP) (yield gpm)
Elen
 (type power)
- (7) electric log No.
 (yes or no)
 (organization running log)
- (8) how well bottom plugged Plastic Plug

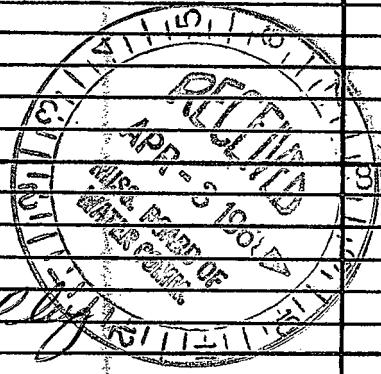

DRILLERS REMARKS:

If well telescopes please sketch and show depths.

GROUND LEVEL

R 2 W

725

		X	

SECTION 2

Please indicate well location X.

ADDITIONAL INFORMATION

If more than one screen, show locations of each on sketch.