

MARSHALL

G27

1-68

MISSISSIPPI  
 BOARD OF WATER COMMISSIONERS  
 416 North State Street  
 Jackson, Mississippi 39201

WATER WELL DRILLERS LOG

Jan 27 1968 R. L. Carpenter Marshall  
 date well completed firm name county well located

LANDOWNER: James Sharp  
 Lamar, Miss.

description of formations encountered	from	to
Surface soil	6	12

(mailing address)

Medison Red sand	12	28
------------------	----	----

WELL LOCATION:

sec. 2 T 2 N R 2 E  
 3 1/2 miles E of Slough  
 (distance) (direction) (nearest town)

Medison White sand	28	60
--------------------	----	----

WELL PURPOSE: Farm  
 (home, irrigation, municipal, industrial)

White Clay	60	67
------------	----	----

WELL COMPLETION DATA:


- (1) diameter (inches) 4
- (2) total depth (feet) 150
- (3) static water level (feet) 90 below top of ground.
- (4) casing Plastic, 144 (material) (depth)  
 if telescope see back. (size)
- (5) screen 6 ft, 144 (length) (depth to top)  
 4 in. Plastic & Gravel (size) (material)
- (6) pump Bucket well (HP) (yield gpm)  
 (type power)
- (7) electric log no (yes or no)  
 (organization running log)

White fine sand and white Clay mixed	67	117
--------------------------------------	----	-----

White coarse sand	117	150
-------------------	-----	-----

(8) how well bottom plugged Plastic Plug

DRILLERS REMARKS:

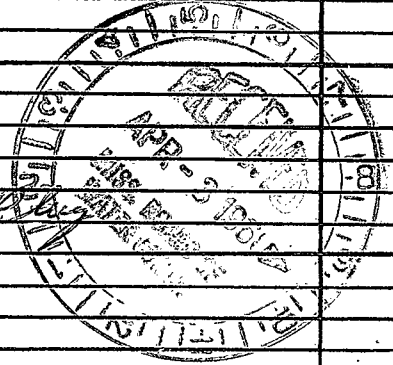

If well telescopes please sketch and show depths.

GROUND LEVEL

R 2 W

+25

		x	

SECTION 2

Please indicate well location X.

ADDITIONAL INFORMATION

If more than one screen, show locations of each on sketch.