

Marshall  
 G 28  
 5-8-68

MISSISSIPPI  
 BOARD OF WATER COMMISSIONERS  
 416 North State Street  
 Jackson, Mississippi 39201

WATER WELL DRILLERS LOG

May 8 - 1968 date well completed  
 P. L. Carpenter firm name  
 Marshall county well located

LANDOWNER:

Jess M. Gue  
 Hudsonville, Miss  
 (mailing address)

description of formations encountered

from to

Surface soil	0	17
medium red sand	17	31
White clay	31	62
Med. white sand	62	100
White clay	100	107
White fine sand	107	118
White clay	118	129
White coarse sand	129	150

WELL LOCATION:

sec. 33 T 2 N R 2 E  
 S W  
 1/2 miles North of Highway  
 (distance) (direction) (nearest town)

WELL PURPOSE:

Home (home, irrigation, municipal, industrial)


WELL COMPLETION DATA:

- (1) diameter (inches) 4
- (2) total depth (feet) 150
- (3) static water level (feet) 100 below top of ground.
- (4) casing Plastic - 144 (material) (depth)  
 (size) if telescope see back.
- (5) screen 6 ft, 144 ft (length) (depth to top)  
 4 in Plastic + gravel (size) (material)
- (6) pump 3/4 HP 12 (yield gpm)  
 elec. (type power)
- (7) electric log no (yes or no)

(organization running log)

- (8) how well bottom plugged Plastic Plug

DRILLERS REMARKS:

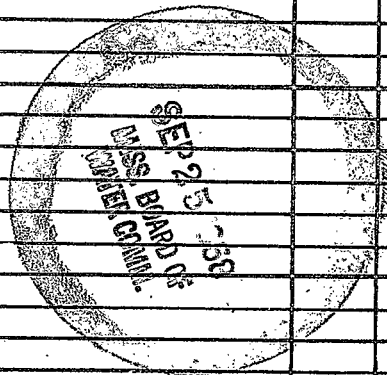


If well telescopes please sketch and show depths.

GROUND LEVEL

R2W

T25

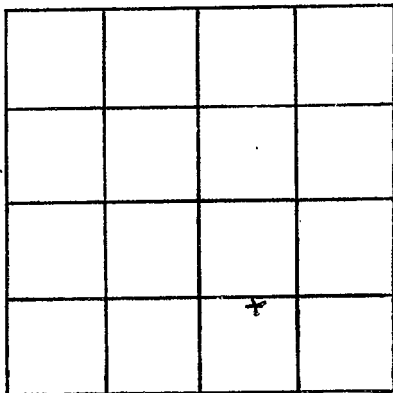

SECTION 33

Please indicate well location X.

ADDITIONAL INFORMATION

If more than one screen, show locations of each on sketch.