

MARSHALL

G32

12-71

MISSISSIPPI BOARD OF WATER COMMISSIONERS
416 North State Street
Jackson, Mississippi 39201

DEC 17 1971

MISS. BD. OF

CODED

WATER WELL DRILLERS LOG

Wilson Well *Convent*
Marshall

date well completed

firm name

county well located

LANDOWNER:

John Jones
Lamar Pt

(mailing address)

description of formations encountered

from to

<i>Yellow c</i>	<i>0</i>	<i>20</i>
<i>Red Sand</i>	<i>20</i>	<i>90</i>
<i>gr</i>	<i>7</i>	<i>120</i>
<i>W. clay</i>	<i>120</i>	<i>170</i>
<i>White Sand</i>	<i>130</i>	<i>200</i>

WELL LOCATION:

sec. *8* T *2* N R *2* E
2 miles *S* of *Slayden*
(distance) (direction) (nearest town)

WELL PURPOSE: *Home*
(home, irrigation, municipal, industrial)

WELL COMPLETION DATA:


- (1) diameter (inches) *16"*
- (2) total depth (feet) *200*
- (3) static water level (feet) *130* below top of ground.
- (4) casing *Plastic*, *200* (material), (depth)
- (size) If telescope see back.
- (5) screen *8*, *200* (length), (depth to top)
- 4*, *Plastic* (size), (material)
- (6) pump *1.5 HP*, *20* (HP), (yield gpm)
- E* (type power)
- (7) electric log _____ (yes or no)
- _____ (organization running log)
- (8) how well bottom plugged _____

CODED

DRILLERS REMARKS:

If well telescopes please sketch and show depths.

GROUND LEVEL

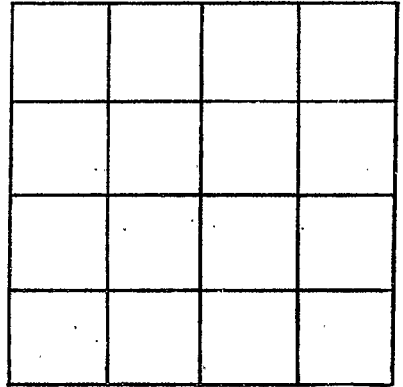

SECTION _____

Please indicate well location X.

ADDITIONAL INFORMATION

If more than one screen,
show locations of each on sketch.