

MARSHALL
G 34
3-11-72

MISSISSIPPI
 BOARD OF WATER COMMISSIONERS
 416 North State Street
 Jackson, Mississippi 39201

CODED

WATER WELL DRILLERS LOG

3-11-1972 Deont West Bumpers well co. Marshall
 date well completed firm name county well located

LANDOWNER:	description of formations encountered	from	to
<u>Clear Creek Baptist Church</u> (mailing address)	<u>clay</u>	0	20
	<u>sand</u>	20	160
WELL LOCATION: sec. <u>26</u> T <u>2</u> N R <u>2</u> E <u>10</u> miles <u>North</u> of <u>Halls Springs</u> (distance) (direction) (nearest town)			
WELL PURPOSE: <u>Drinking</u> (home, irrigation, municipal, industrial)			
WELL COMPLETION DATA: (1) diameter (inches) <u>4"</u> (2) total depth (feet) <u>160 feet</u> (3) static water level (feet) <u>120 feet</u> below above top of ground. (4) casing <u>PVC</u> <u>160 feet</u> (material) (depth) (size) if telescope see back. (5) screen <u>6'4"</u> <u>154 feet</u> (length) (depth to top) <u>4"</u> <u>Gravel wall</u> (size) (material) (6) pump <u>3/4</u> <u>14</u> (HP) (yield gpm) (type power) (7) electric log <u>elect</u> (yes or no) (organization running log) (8) how well bottom plugged <u>4" cap</u>			
DRILLERS REMARKS:			


CODED

ADD 7 7/2
 3/12

MISS. DEPT. OF AGRICULTURE
 WATER DIVISION

If well telescopes please sketch and show depths.

GROUND LEVEL

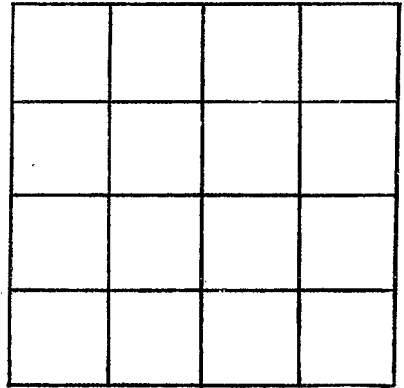

SECTION _____

Please indicate well location X.

ADDITIONAL INFORMATION

If more than one screen,
show locations of each on sketch.