

**MARSHALL**  
**G 35**  
**2-14-72**

MISSISSIPPI  
 BOARD OF WATER COMMISSIONERS  
 416 North State Street  
 Jackson, Mississippi 39201

**CODED**

WATER WELL DRILLERS LOG

Feb. 14 1972 R. L. Carpenter Marshall  
 date well completed firm name county well located

LANDOWNER:	description of formations encountered	from	to
Messie J Bailey Hudsonville, Miss	Surface Soil	0	18
RFD (mailing address)	Med. White Sand	18	50
WELL LOCATION: sec 27 T 2 N R 2 E 2 miles northeast of (distance) (direction) (nearest town)	White Clay	50	67
WELL PURPOSE: Home (home, irrigation, municipal, industrial)	White Fine Sand	67	93
WELL COMPLETION DATA: (1) diameter (inches) 4	White Clay	93	105
(2) total depth (feet) 180	Med white sand	105	140
(3) static water level (feet) 137 below top of ground.	White Coarse Sand	140	180
(4) casing Plastic 174 ft. (material) (depth)			
(size) if telescope see back.			
(5) screen 6 ft 174 ft (length) (depth to top)			
4 in Plastic Strawl (size) (material)			
(6) pump 3/4 10 (HP) (yield gpm)			
Elec. (type power)			
(7) electric log No (yes or no)			
(organization running log)			
(8) how well bottom plugged Plastic Plug			
DRILLERS REMARKS:			


**CODED**

AUG - 4 1972

MISS. DIV. OF  
 WATER COMMISSIONERS

If well telescopes please sketch and show depths.

GROUND LEVEL

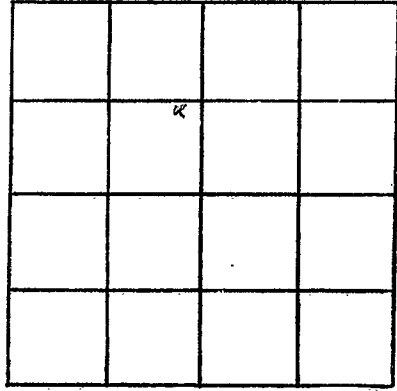

SECTION 22

Please indicate well location X.

ADDITIONAL INFORMATION

If more than one screen,  
show locations of each on sketch.