

MARSHALL
G36
8-29-72

MISSISSIPPI
 BOARD OF WATER COMMISSIONERS
 416 North State Street
 Jackson, Mississippi 39201

WATER WELL DRILLERS LOG

CODED

8/29 1972 DEAN HUNT BUMPAS^{well} MARSHALL
 date well completed firm name county well located

LANDOWNER:	description of formations encountered	from	to
WILL H. MULL LAMAR, MISS. (mailing address)		clay sand	0
WELL LOCATION: sec 27 T 2 N R 2 E 5 miles SW of Hudsonville (distance) (direction) (nearest town)			
WELL PURPOSE: DWELLING (home, irrigation, municipal, industrial)			
WELL COMPLETION DATA:			
(1) diameter (inches) 4"			
(2) total depth (feet) 120 feet			
(3) static water level (feet) 90 feet below top of ground			
(4) casing PVC 120 feet (material) (depth)			
(size) If telescope see back.			
(5) screen 7 ft. 113 feet (length) (depth to top)			
4" sand well (size) (material)			
(6) pump 3/4 HP 10 (HP) (yield gpm)			
(type power)			
(7) electric log elect. (yes or no)			
(organization running log)			
(8) how well bottom plugged 4" cap			



CODED

SEP 15 1972

MISS. BD. OF
 WATER CONTROL

DRILLERS REMARKS:

If well telescopes please sketch and show depths.

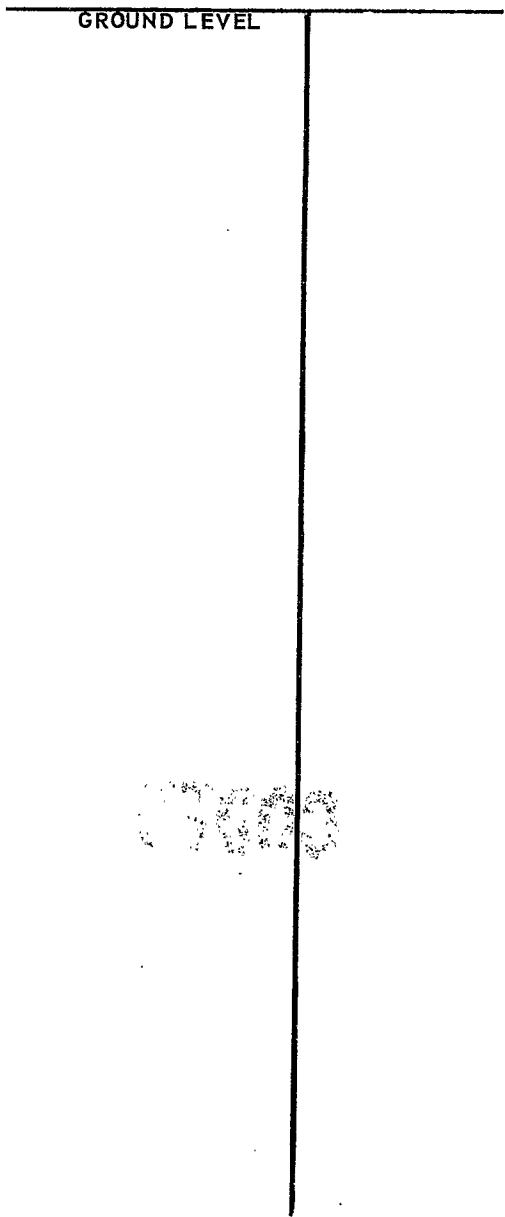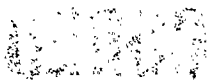

SECTION _____

Please indicate well location X.

ADDITIONAL INFORMATION

If more than one screen, show locations of each on sketch.

276