

MARSHALL
G 38
8-14-72

MISSISSIPPI
BOARD OF WATER COMMISSIONERS
416 North State Street
Jackson, Mississippi 39201

Inf requested
PTM 11/27/72
CODED

WATER WELL DRILLERS LOG

8-14-72 19 R. W. Wilson Marshall
date well completed firm name county well located

LANDOWNER: Eddie Ambrose

description of formations encountered	from to	
<u>Red Clay</u>	<u>0</u>	<u>11</u>
<u>Red sand</u>	<u>11</u>	<u>15</u>
<u>Yellow clay & white clay</u>	<u>15</u>	<u>30</u>
<u>White sand & white clay</u>	<u>30</u>	<u>90</u>
<u>White sand</u>	<u>90</u>	<u>132</u>
<u>white clay</u>	<u>132</u>	<u>135</u>
<u>white clay & white clay</u>	<u>135</u>	<u>145</u>
<u>white sand</u>	<u>145</u>	<u>180</u>

Lamar, Miss
(mailing address)

WELL LOCATION:

sec. 32 T 2 N R 2 E
(S) (W)
miles of
(distance) (direction) (nearest town)

WELL PURPOSE:

(home, irrigation, municipal, industrial)

WELL COMPLETION DATA:

- (1) diameter (inches) 4
- (2) total depth (feet) 180
- (3) static water level (feet) 120 below top of ground.
- (4) casing P, 176,
(material) (depth)
(size) if telescope see back.
- (5) screen 4, 176
(length) (depth to top)
4, Gravel pack
(size) (material)
- (6) pump 3/4, 10
(HP) (yield gpm)
electric
(type power)
- (7) electric log _____
(yes or no)

(organization running log)
- (8) how well bottom plugged 4 inch
plastic cap


DRILLERS REMARKS:

NOV 27 1972

MISS. DIV. OF
WATER COM.

If well telescopes please
sketch and show depths.

GROUND LEVEL

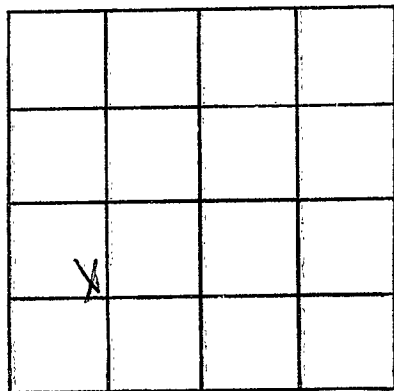

SECTION 27

Please indicate well location X.

ADDITIONAL INFORMATION

If more than one screen,
show locations of each on sketch.