

MARSHALL
G 39
7-21-72

MISSISSIPPI
 BOARD OF WATER COMMISSIONERS
 416 North State Street
 Jackson, Mississippi 39201
WATER WELL DRILLERS LOG

CODED

7-21-72 19 R. W. Wilson Marshall
 date well completed firm name county well located

LANDOWNER: Joe. Luellen
Rt 1 Box 85A
Lamar, Miss
 (mailing address)

description of formations encountered	from	to
<u>red clay red sand</u>	<u>0</u>	<u>30</u>
<u>red sand, white clay</u>		
<u>white sand</u>	<u>30</u>	<u>60</u>
<u>red sand</u>	<u>60</u>	<u>135</u>
<u>red sand, white clay</u>		
<u>white sand</u>	<u>135</u>	<u>150</u>
<u>white sand</u>	<u>150</u>	<u>190</u>

WELL LOCATION:
 sec. 27 T 2 N R 2 E
 (distance) (direction) (nearest town)

WELL PURPOSE:
 (home, irrigation, municipal, industrial)

WELL COMPLETION DATA:

(1) diameter (inches) 4

(2) total depth (feet) 180

(3) static water level (feet) 140 below above top of ground.

(4) casing 172
 (material) (depth)
 if telescope see back.
 (size)

(5) screen 8 172
 (length) (depth to top)
4 brand pack
 (size) (material)

(6) pump 3/4 10
 (HP) (yield gpm)
electric
 (type power)

(7) electric log _____
 (yes or no)
 (organization running log)

(8) how well bottom plugged 4 inches
plastic cap


DRILLERS REMARKS:

NOV 27 1972

MISS. ST. OF
 WATER COMES

If well telescopes please
sketch and show depths.

GROUND LEVEL

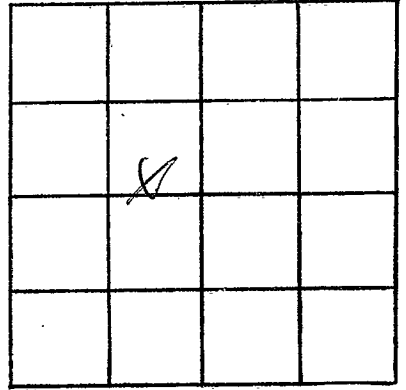

SECTION 27

Please indicate well location X.

ADDITIONAL INFORMATION

If more than one screen,
show locations of each on sketch.