

MISSISSIPPI  
 BOARD OF WATER COMMISSIONERS  
 416 North State Street  
 Jackson, Mississippi 39201  
 WATER WELL DRILLERS LOG

**CODED**

**MARSHALL**  
**G 40**  
**8-8-72**

8-8-72 19 R.W. Wilson Marshall  
 date well completed firm name county well located

LANDOWNER: Willie Raymond description of formations encountered from to

Lamar Miss.  
 (mailing address)

WELL LOCATION:  
 sec. 27 T. 2 N. R. 7 E. (S) (W)  
 (distance) miles of (direction) (nearest town)

Brown Clay	0	15
Brown sand	15	38
Red sand	38	45
White sand	45	67
White Clay	67	71
White sand	71	165

WELL PURPOSE:  
 (home, irrigation, municipal, industrial)


- WELL COMPLETION DATA:
- (1) diameter (inches) 4
  - (2) total depth (feet) 165
  - (3) static water level (feet) 130 below above top of ground.
  - (4) casing 161  
 (material) (depth)  
 (size) if telescope see back.
  - (5) screen 4 161  
 (length) (depth to top)  
4 Gravel Pack  
 (size) (material)
  - (6) pump 3/4 10  
 (HP) (yield gpm)  
electric  
 (type power)
  - (7) electric log \_\_\_\_\_  
 (yes or no)  
 \_\_\_\_\_  
 (organization running log)
  - (8) how well bottom plugged 4 inch  
plastic cap

DRILLERS REMARKS:

NOV 27 1972

If well telescopes please sketch and show depths.

GROUND LEVEL

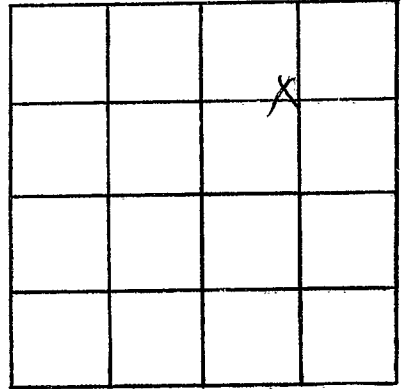

SECTION 27

Please indicate well location X.

ADDITIONAL INFORMATION

If more than one screen,  
show locations of each on sketch.