

MARSHALL
G 41
3-23-73

MISSISSIPPI
 BOARD OF WATER COMMISSIONERS
 416 North State Street
 Jackson, Mississippi 39201

CODED

WATER WELL DRILLERS LOG

3-23 1973 Robert W. Wilcox Marshall
 date well completed firm name county well located

LANDOWNER:
Nathaniel James
Rt 1
Osman, Miss
 (mailing address)

WELL LOCATION:
 sec. 10 T-2 N R-2 E
 (S) (W)

_____ miles _____ of _____
 (distance) (direction) (nearest town)

description of formations encountered	from	to
<u>Brown clay</u>	<u>0</u>	<u>10</u>
<u>Red Sand</u>	<u>10</u>	<u>38</u>
<u>white Sand</u>	<u>38</u>	<u>87</u>
<u>white clay</u>	<u>87</u>	<u>90</u>
<u>white Sand</u>	<u>90</u>	<u>180</u>

WELL PURPOSE:
 (home, irrigation, municipal, industrial)

WELL COMPLETION DATA:

(1) diameter (inches) 4

(2) total depth (feet) 180

(3) static water level (feet) 125 below/above top of ground.

(4) casing _____ (material), 172 (depth)
 _____ if telescope see back.
 (size)

(5) screen 8 _____ (length), 172 (depth to top)
1/2 _____ (size), _____ (material)

(6) pump 3/4 _____ (HP), 10 (yield gpm)
electric (type power)

(7) electric log _____ (yes or no)
 _____ (organization running log)

(8) how well bottom plugged 4" plastic
cap


CODED

DRILLERS REMARKS:

APR 9 1973

If well telescopes please sketch and show depths.

GROUND LEVEL

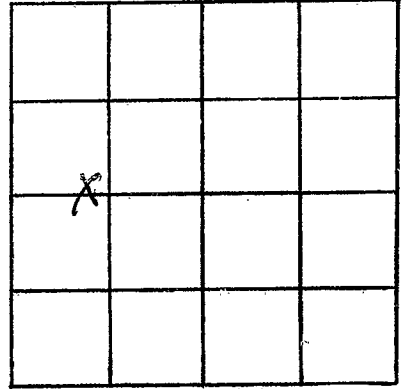

SECTION 10

Please indicate well location X.

ADDITIONAL INFORMATION

If more than one screen,
show locations of each on sketch.