

MARSHALL
G 42
5-8-73

MISSISSIPPI
 BOARD OF WATER COMMISSIONERS
 416 North State Street
 Jackson, Mississippi 39201

CODED

WATER WELL DRILLERS LOG

5-8 1973 Perimeter Services ^{well} Marshall
 date well completed firm name county well located

LANDOWNER:
John Reel
Jamaica, miss
 (mailing address)

description of formations encountered	from	to
	Clay	0
Sand	10	160

WELL LOCATION:
 sec. 26 T. 2 N. R. 2 E
6 miles North of Wetzel
 (distance) (direction) (nearest town)

WELL PURPOSE: Drinking
 (home, irrigation, municipal, industrial)


- WELL COMPLETION DATA:
- diameter (inches) 4"
 - total depth (feet) 160 feet
 - static water level (feet) 25 feet below top of ground.
 - casing PVC (material), 160 feet (depth)
 (size) if telescope see back.
 - screen 24" (length), 153 feet (depth to top)
4" (size) gravel wash (material)
 - pump 3/4 (HP), 14 (yield gpm)
 (type power)
 - electric log yes (yes or no)
 (organization running log)
 - how well bottom plugged 4" cap.

CODED

DRILLERS REMARKS:

If well telescopes please sketch and show depths.

GROUND LEVEL

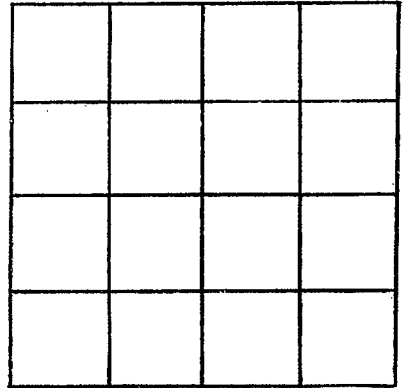

SECTION _____

Please indicate well location X.

ADDITIONAL INFORMATION

If more than one screen, show locations of each on sketch.