

G 49
MARSHALL
4-13-73

MISSISSIPPI
BOARD OF WATER COMMISSIONERS
416 North State Street
Jackson, Mississippi 39201

COPIED

WATER WELL DRILLERS LOG

April 13, 1973 R.L. Carpenter Marshall
date well completed firm name county well located

LANDOWNER: Walker Mitchell
Lamar, Miss
RFO
(mailing address)

WELL LOCATION:
sec. 10 T-2 N R-2 E
0 S 5 W
4 miles Southeast of Snyder
(distance) (direction) (nearest town)

WELL PURPOSE: None
(home, irrigation, municipal, industrial)

- WELL COMPLETION DATA:
- (1) diameter (inches) 4
- (2) total depth (feet) 150
- (3) static water level (feet) 114 below/above top of ground.
- (4) casing Plastic, 144ft.
(material) (depth)
- If telescope see back.
(size)
- (5) screen 6ft., 144ft.
(length) (depth to top)
- 4in., Plastic & thread
(size) (material)
- (6) pump 3/4 10
(HP) (yield gpm)
- Elec
(type power)
- (7) electric log no
(yes or no)
- (organization running log)
- (8) how well bottom plugged Plastic cap


description of formations encountered	from	to
Surface Soil	0	19
Med. Red Sand	19	45
Med. white sand	45	76
white clay & white fine sand	76	120
white coarse sand	125	150

DRILLERS REMARKS:

APR 17 1973

If well telescopes please
sketch and show depths.

GROUND LEVEL

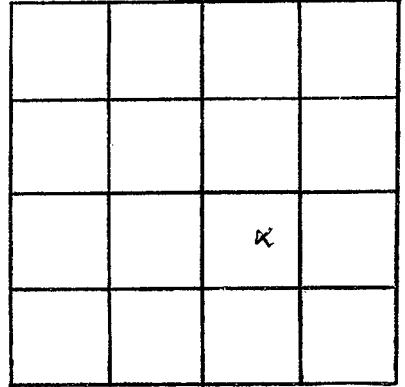

SECTION 10

Please indicate well location X.

ADDITIONAL INFORMATION

If more than one screen,
show locations of each on sketch.