

G 48
 MARSHALL
 6-20-73

MISSISSIPPI
 BOARD OF WATER COMMISSIONERS
 416 North State Street
 Jackson, Mississippi 39201

COPIED

WATER WELL DRILLERS LOG

June 20 1973 R.L. Carpenter Marshall
 date well completed firm name county well located

LANDOWNER: L.J. Coleman
 Lancer, Miss.

description of formations encountered from to

R.F.D.
 (mailing address)

Surface Soil 8 21

WELL LOCATION:
 sec. 7 T. 2 N R. 2 E
 3 miles S of Mt. Pleasant White Clay
 (distance) (direction) (nearest town)

Med. Red Sand 21 40

Med. White Sand 40 91

WELL PURPOSE: Home
 (home, irrigation, municipal, industrial)

White Coarse Sand 91 110

WELL COMPLETION DATA:

White Clay 110 126

(1) diameter (inches) 4

White Fine Sand 126 141

(2) total depth (feet) 185

White Coarse Sand 141 185

(3) static water level (feet) 180 below top of ground.

(4) casing Plastic 174 ft.
 (material) (depth)

(5) screen 6 ft. 174 ft.
 (length) (depth to top)

4 in. Plastic & Thread
 (size) (material)

(6) pump 3/4 10
 (HP) (yield gpm)

2 hp.
 (type power)

(7) electric log No
 (yes or no)

(8) how well bottom plugged Plastic Cap


DRILLERS REMARKS:

AUG 17 1973

MISS. BD. OF
 WATER COMMISSIONERS

If well telescopes please sketch and show depths.

GROUND LEVEL

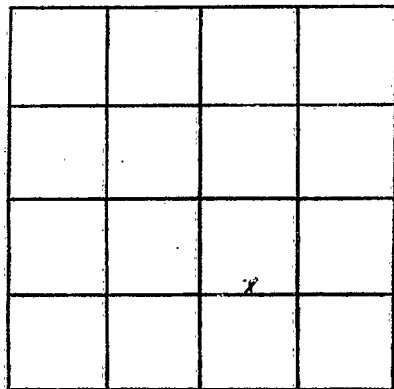

SECTION 7

Please indicate well location X.

ADDITIONAL INFORMATION

If more than one screen,
show locations of each on sketch.