

125

G 49
MARSHALL
4-6-73

MISSISSIPPI
BOARD OF WATER COMMISSIONERS
416 North State Street
Jackson, Mississippi 39201

CODED

WATER WELL DRILLERS LOG

4-6-1973 date well completed
Robert W. Wilson firm name
La. Marshall county well located

LANDOWNER: Louis Jones Jr.
Darman, Miss.

(mailing address)

WELL LOCATION:

sec. 10 2 N 2 E
5 10
miles (distance) of (direction) of (nearest town)

WELL PURPOSE:

(home, irrigation, municipal, industrial)

WELL COMPLETION DATA:

- (1) diameter (inches) 4
- (2) total depth (feet) 165
- (3) static water level (feet) 120 below above top of ground.
- (4) casing Plastic, 165 (material) (depth)
- (size) if telescope see back.
- (5) screen 8, 159 (length) (depth to top)
4, granular (size) (material)
- (6) pump 3/4, 10 (HP) (yield gpm)
electric (type power)
- (7) electric log (yes or no)
- (organization running log)
- (8) how well bottom plugged 2"
plastic cap

description of formations encountered	from	to
red clay, red sand	0	30
white sand real coarse	30	45
white clay	45	60
white clay & sand	60	75
white sand	75	122
white clay & sand	122	135
white coarse	135	165


CODED

DRILLERS REMARKS:

AUG 28 1973

If well telescopes please sketch and show depths.

GROUND LEVEL

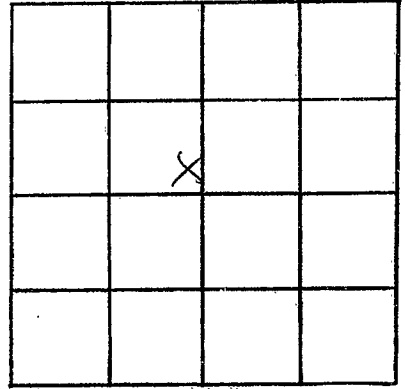

SECTION 20

Please indicate well location X:

ADDITIONAL INFORMATION

If more than one screen,
show locations of each on sketch.