

MARSHALL

G 50

7-21-73

MISSISSIPPI BOARD OF WATER COMMISSIONERS
416 North State Street
Jackson, Mississippi 39201

CODED

WATER WELL DRILLERS LOG

7-21-1973
date well completed

Bob Smith
firm name

Marshall
county well located

LANDOWNER:

Walter Boyd
Stacyen Moss
(mailing address)

description of formations encountered

from to

Clay sint		8
white sand	8	155
white clay	155	170
white sand	170	186

WELL LOCATION:

sec. 16 T 2 N R 2 E
4 1/2 miles SE of Stacyen
(distance) (direction) (nearest town)

WELL PURPOSE: Home
(home, irrigation, municipal, industrial)

WELL COMPLETION DATA:

- (1) diameter (inches) 4
- (2) total depth (feet) 186
- (3) static water level (feet) 150 below top of ground
- (4) casing (material) P. lath (depth) 186
- (5) screen (length) 20 (depth to top) 166
- (6) pump (HP) 1/2 (yield gpm) 10
- (7) electric log (yes or no) no

If telescope see back.
(size)

(size) (material) P. lath

(type power) Elec

(organization running log)

(8) how well bottom plugged plugged


DRILLERS REMARKS:

SEP 21 1973

MISS. BD. OF WATER COMMISSIONERS

If well telescopes please sketch and show depths.

GROUND LEVEL

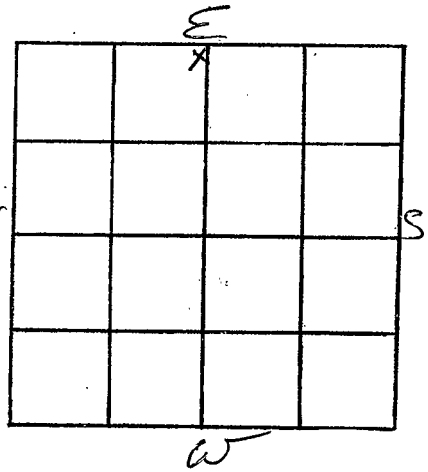

SECTION 16

Please indicate well location X.

ADDITIONAL INFORMATION

If more than one screen, show locations of each on sketch.