

MARSHALL
G 51
10-22-73

MISSISSIPPI
 BOARD OF WATER COMMISSIONERS
 416 North State Street
 Jackson, Mississippi 39201 **CODED**
WATER WELL DRILLERS LOG

Oct. 22 1973 R. L. Carpenter Marshall
 date well completed firm name county well located

LANDOWNER: Honica Mackey

Holly Springs
Miss.

(mailing address)

description of formations encountered

from to

<u>Surface Soil</u>	<u>0</u>	<u>18</u>
<u>Med. L. Coarse white sand</u>	<u>18</u>	<u>53</u>
<u>white fine sand</u>	<u>53</u>	<u>78</u>
<u>white coarse sand</u>	<u>78</u>	<u>110</u>
<u>white clay</u>	<u>110</u>	<u>117</u>
<u>white coarse sand</u>	<u>117</u>	<u>170</u>

WELL LOCATION:

sec 17 T 2 N R 2 E
3 miles south of Slagden
 (distance) (direction) (nearest town)

WELL PURPOSE: None
 (home, irrigation, municipal, industrial)

WELL COMPLETION DATA:

- diameter (inches) 4 in.
- total depth (feet) 170
- static water level (feet) 117 below above top of ground.
- casing Plastic 164 ft.
 (material) (depth)
 (size) If telescope see back.
- screen 6 ft. 164 ft.
 (length) (depth to top)
4 in. Plastic & Braided
 (size) (material)
- pump 3/4 10
 (HP) (yield gpm)
Elec.
 (type power)
- electric log No.
 (yes or no)


(organization running log)

(8) how well bottom plugged Plastic Cap

DRILLERS REMARKS:

CODED

CODED

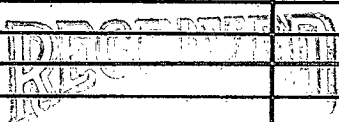

MAR 18 1974

