

MARSHALL

G 52

5-17-74

MISSISSIPPI BOARD OF WATER COMMISSIONERS
416 North State Street
Jackson, Mississippi 39201

CODED

WATER WELL DRILLERS LOG

May 17 1974
date well completed

R. L. Carpenter
firm name

Marshall
county well located

LANDOWNER: L. B. Hurdle

Lamar, Miss

R. F. D

(mailing address)

description of formations encountered

from

to

Surface Soil

0 23

med. white sand

23 80

White Clay L

80 105

White fine sand

med. & coarse white sand

105 184

White coarse sand

184 214

WELL LOCATION:

sec 27 T 2 N R 2 E
2 miles North east of Atmy
(distance) (direction) (nearest town)

WELL PURPOSE:

Farm
(home, irrigation, municipal, industrial)

WELL COMPLETION DATA:

(1) diameter (inches) 4 in.

(2) total depth (feet) 214

(3) static water level (feet) 165 below top of ground.

(4) casing Plastic, 208 ft.
(material) (depth)

(size) if telescope see back.

(5) screen 6 ft., 208 ft.
(length) (depth to top)

4 in., Plastic & gravel
(size) (material)

(6) pump 3/4, 10
(HP) (yield gpm)

Elec.
(type power)

(7) electric log No.
(yes or no)

(organization running log)

(8) how well bottom plugged Plastic cap


DRILLERS REMARKS:



MAY 22 1974

If well telescopes please sketch and show depths.

GROUND LEVEL

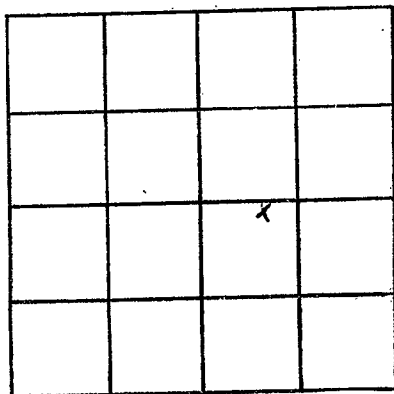

SECTION 27

Please indicate well location X.

ADDITIONAL INFORMATION

If more than one screen, show locations of each on sketch.