

MARSHALL
G 56
3-4-75

MISSISSIPPI
 BOARD OF WATER COMMISSIONERS
 416 North State Street
 Jackson, Mississippi 39201

WATER WELL DRILLERS LOG

3-4
 date well completed

1975 Dean Hartman
 firm name

Marshall
 county well located

LANDOWNER:

Fox W. Teef
Holly Springs Miss.
 (mailing address)

description of formations encountered

clay
sand

from	to
<u>0</u>	<u>30</u>
<u>30</u>	<u>180</u>


WELL LOCATION:

sec. 35 T 2 N R 2 E
6 miles NORTH of HOLLY SPRINGS
 (distance) (direction) (nearest town)

WELL PURPOSE: Drilling
 (home, irrigation, municipal, industrial)

WELL COMPLETION DATA:

- (1) diameter (inches) 4"
- (2) total depth (feet) 180 feet
- (3) static water level (feet) 110 below above top of ground.
- (4) casing PVC, 180 feet
 (material) (depth)
 (size) if telescope see back.
- (5) screen 7 FT., 173 feet
 (length) (depth to top)
4", gravel wall
 (size) (material)
- (6) pump 3/4, 14
 (HP) (yield gpm)
 (type power)
- (7) electric log elect.
 (yes or no)
 (organization running log)
- (8) how well bottom plugged 4' Cop.

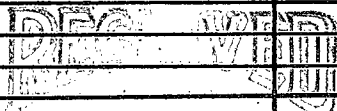


APR - 7 1975

DRILLERS REMARKS:

If well telescopes please sketch and show depths.

GROUND LEVEL

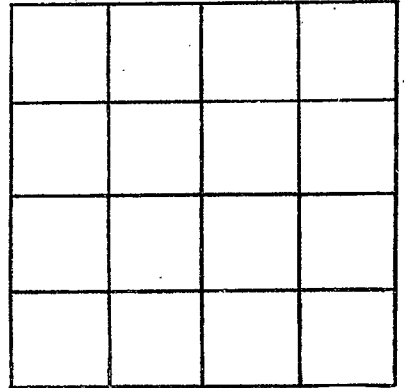

SECTION _____

Please indicate well location X.

ADDITIONAL INFORMATION

A series of horizontal lines providing space for additional information.

If more than one screen, show locations of each on sketch.