

Marshall  
G 57  
10-25-76

MISSISSIPPI  
BOARD OF WATER COMMISSIONERS  
416 North State Street  
Jackson, Mississippi 39201

WATER WELL DRILLERS LOG

CODED

Oct 25 1974 R. L. Carpenter Marshall  
date well completed firm name county well located


LANDOWNER:	description of formations encountered	from	to
Lanary, Miss RFD (mailing address)	Superior Soil	0	21
WELL LOCATION: sec. 8 T. 2 N. R. 2 E 16N 2 miles south of Sledge (distance) (direction) (nearest town)	Coarse Red Sand	21	38
WELL PURPOSE: Home (home, irrigation, municipal, industrial)	Med. White Sand	38	85
WELL COMPLETION DATA: (1) diameter (inches) 4 (2) total depth (feet) 160 (3) static water level (feet) 165 below top of ground. (4) casing Plaster, 154 ft. (material) (depth) (size) If telescope see back. (5) screen 6' 154' (length) (depth to top) 4 in. Plaster (size) (material) (6) pump 1/2 9 (HP) (yield gpm) Elev. (type power) (7) electric log No. (yes or no) (organization running log) (8) how well bottom plugged Plaster	White Clay	85	110
	Med. White Sand	110	126
	White Coarse Sand	126	160
DRILLERS REMARKS:			

REGISTERED  
JUL 21 1975

MISS. BD. OF WATER COMMISSIONERS

If well telescopes please sketch and show depths.

GROUND LEVEL

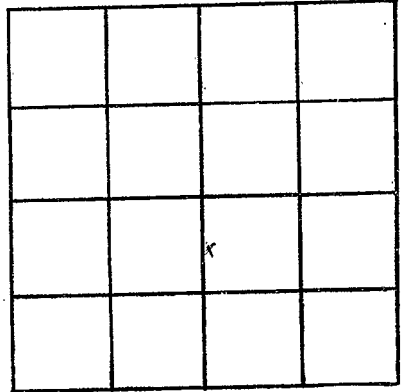

SECTION 8

Please indicate well location X.

ADDITIONAL INFORMATION

If more than one screen,  
show locations of each on sketch.