

Marshall
G.59
12-14-74

MISSISSIPPI
BOARD OF WATER COMMISSIONERS
416 North State Street
Jackson, Mississippi 39201

WATER WELL DRILLERS LOG

CODED

Dec. 14 1974
date well completed

R. L. Carpenter
firm name

Marshall
county well located

LANDOWNER: Morris Halentine
Lamar, Miss.

R. F. D.
(mailing address)

WELL LOCATION:

sec. 6 T-2 N R-2 E 15E
1/4 miles South of Sloyden
(distance) (direction) (nearest town)

WELL PURPOSE:

Home
(home, irrigation, municipal, industrial)

WELL COMPLETION DATA:

- (1) diameter (inches) 4
- (2) total depth (feet) 190
- (3) static water level (feet) 160 below top of ground.
- (4) casing Plastic, 184'
(material) (depth)

_____ If telescope see back.
(size)

- (5) screen 6' , 184'
(length) (depth to top)
4in. , Plastic & Gravel
(size) (material)
- (6) pump 3/4 , 18
(HP) (yield gpm)

Elec.
(type power)

- (7) electric log No.
(yes or no)

_____ (organization running log)

- (8) how well bottom plugged Plastic cap

description of formations encountered

from to

Surface Soil	0	22
Medy. Fine Red Sand	22	45
White White coarse sand	45	93
White Clay & White Fine Sand	93	120
Med. White Sand	120	143
White Coarse Sand	143	190



DRILLERS REMARKS:

RECEIVED
DEC 22 1974

MISS. Bd. of Water Comm.

If well telescopes please sketch and show depths.

GROUND LEVEL

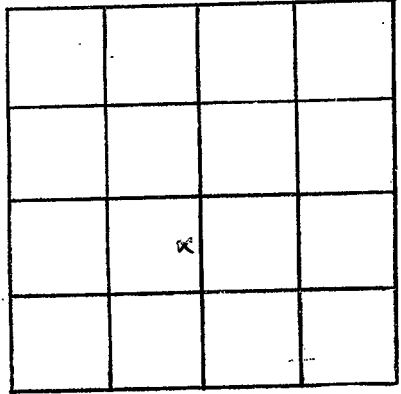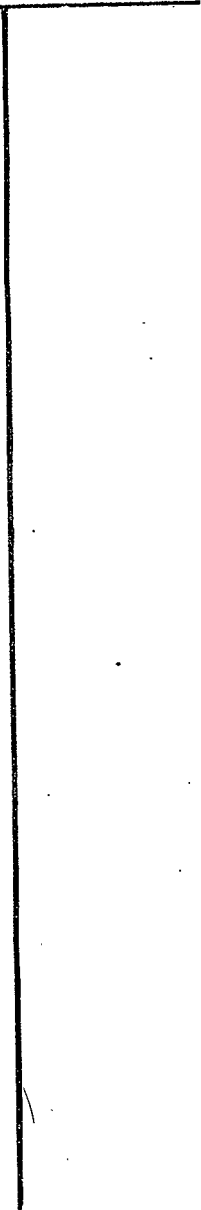

SECTION 6

Please indicate well location X.

ADDITIONAL INFORMATION

Lined area for additional information.

If more than one screen, show locations of each on sketch.