

MARSHALL

G 60

9-17-75

MISSISSIPPI
 BOARD OF WATER COMMISSIONERS
 416 North State Street
 Jackson, Mississippi 39201

CODED

WATER WELL DRILLERS LOG

SEPT 17 1975
date well completed

BY Billy R. SIMPSON
firm name

MARSHALL
county well located

LANDOWNER:

JACK WITTJEN

Holly Springs, Miss
(mailing address)

description of formations encountered

SURFACE CLAY

FINE SAND

YELLOW CLAY + SAND

COARSE SAND

from

to

0

8

8

22

22

90

90

160

WELL LOCATION:

sec. 35 T 2 R 2 S W
0 miles of Hudsonville
(distance) (direction) (nearest town)

WELL PURPOSE: HOME
(home, irrigation, municipal, industrial)

WELL COMPLETION DATA:

- (1) diameter (inches) 4
- (2) total depth (feet) 160
- (3) static water level (feet) 60 below top of ground
- (4) casing POC 154
(material) (depth)

if telescope see back.
(size)

- (5) screen 6' 154
(length) (depth to top)

4" POC
(size) (material)

- (6) pump 3/4 10
(HP) (yield gpm)

ELEC
(type power)

- (7) electric log NO
(yes or no)


(organization running log)

- (8) how well bottom plugged POC CAP

DRILLERS REMARKS:

If well telescopes please
sketch and show depths.

GROUND LEVEL

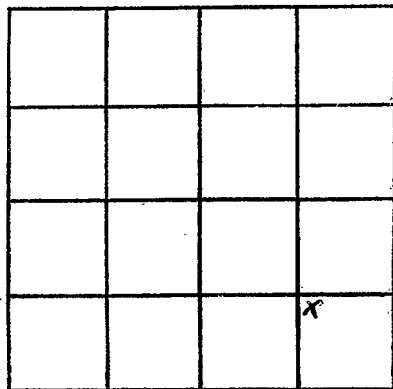

SECTION 35

Please indicate well location X.

ADDITIONAL INFORMATION

If more than one screen,
show locations of each on sketch.