

MARSHALL
G 61
5-3-73

MISSISSIPPI
BOARD OF WATER COMMISSIONERS
416 North State Street
Jackson, Mississippi 39201

CODED

WATER WELL DRILLERS LOG

5-3 1973 Beant Kent Burpa Co. well Marshall
date well completed firm name county well located

LANDOWNER:
James Cera
At Lamar Miss.
(mailing address)

WELL LOCATION:
sec. 14 T 2 N R 2 E
6 miles North of Holly Springs
(distance) (direction) (nearest town)

WELL PURPOSE: Drill
(home, irrigation, municipal, industrial)

WELL COMPLETION DATA:
(1) diameter (inches) 4"
(2) total depth (feet) 230 feet
(3) static water level (feet) 175 below above top of ground.
(4) casing pvc, 230 feet (material) (depth)
(size) if telescope see back.
(5) screen 7ft, 223 feet (length) (depth to top)
4" gravel (size) (material)
(6) pump 3/4, 14 (HP) (yield gpm)
(type power)
(7) electric log Elect. (yes or no)
(organization running log)
(8) how well bottom plugged 4" cap.

description of formations encountered	from	to
	sand	0
clay	0	20
Sand	20	80
clay	80	90
Sand	90	230

CODED


JUN 8 1973

MISSISSIPPI BOARD OF WATER COMMISSIONERS

DRILLERS REMARKS:

If well telescopes please sketch and show depths.

GROUND LEVEL

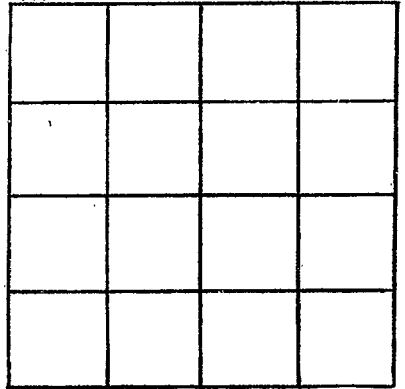

SECTION _____

Please indicate well location X.

ADDITIONAL INFORMATION

If more than one screen,
show locations of each on sketch.