

MISSISSIPPI DEPARTMENT OF ENVIRONMENTAL QUALITY

Office of Land and Water Resources

P. O. Box 10631
Jackson, MS 39289-0631

WATER WELL DRILLERS LOG

COUNTY WELL LOCATED
Marshall

WELL NUMBER CODED

G-75

DATE WELL COMPLETED
1-20-04

PERMIT NUMBER
0-162

NAME OF DRILLING FIRM
Larry Carpenter

Well Co

NAME & MAILING ADDRESS OF LANDOWNER
Southern Homes
420 East Van Dorn Ave
Holly Springs MS

Latitude:
Longitude:

WELL LOCATION. SEC TOWNSHIP RANGE
18 2 N 2 E

DISTANCE DIRECTION NEAREST TOWN
3 Miles South of Snyder

OTHER LANDMARK

WELL PURPOSE: Home, Irrigation, Municipal, Industrial, Fish Pond, etc.
Home

PUMP DATA

PUMP TYPE (Circle One):
Submersible, Turbine, Jet, Flowing Well,
Other (Describe)

POWER TYPE (Circle One):
Electric, Tractor, Diesel, Gasoline, Butane,
Other (Describe) H/P

DESCRIPTION OF FORMATIONS ENCOUNTERED	FROM	TO
<u>Surface Sand</u>	<u>0</u>	<u>15</u>
<u>Med red Sand</u>	<u>15</u>	<u>35</u>
<u>Fine white sand</u>	<u>35</u>	<u>75</u>
<u>White sand</u>	<u>75</u>	<u>110</u>
<u>Med white sand</u>	<u>110</u>	<u>135</u>
<u>Coarse white sand</u>	<u>135</u>	<u>180</u>

WELL DATA

Well Depth <u>180</u>	Casing Diameter (In.) <u>4</u>	Casing Length (Ft.) <u>170</u>
Type of Casing <u>PVC</u>	Hole Depth <u>180</u>	Depth to Static Water Level <u>120</u>

TYPE OF COMPLETION: (Circle One or More):
Gravel Packed, Underreamed, Telescoped,
Natural Development, Open Hole, Other
(Describe)

WELL GROUTED TO A DEPTH OF 10 FEET
Type Grout (circle one): Cement, Bentonite, or Mix

SCREEN DATA

Diameter - Inches <u>4</u>	Length - Feet <u>10</u>	Slot Size - Inches <u>.013</u>
Screen Type <u>PVC</u>	Depth to Bottom - Feet <u>180</u>	

RECEIVED

AUG 02 2004

BY: OLWR

Top of Lap Pipe or Reduction in Casing
FEET IF TELESCOPED OR MORE THAN ONE SCREEN: USE BACK PAGE

I certify that the well was drilled, constructed and completed in accordance with all applicable Requirements of the Mississippi Department of Environmental Quality and/or the Mississippi Department of Health regulations and state laws.


Larry Carpenter 0-162
Signature of Licensed Driller and License No.

2-15-04
Date

Additional Information Required On Back

If well telescopes please sketch and show depths.

GROUND LEVEL

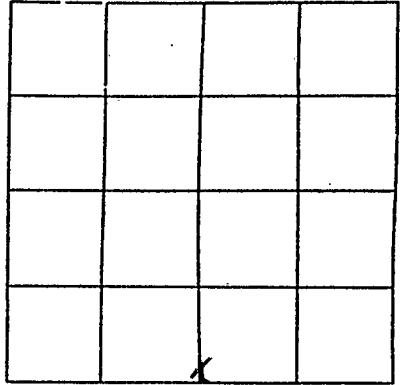

SECTION 18

Please indicate well location X.

Pump Capacity (GPM)	No. of Stages	Setting Depth
<u>12</u>	<u>11</u>	<u>150</u> FT.

PUMP TEST

Well yielded 25 GPM with
a drawdown of 5 ft.
after 2 hours of pumping

LOG DATA

TYPE OF LOG RUN (Circle One): No Log Run
Electric, Gamma Ray, Density, Sonic, Neutron,
Other (Describe) _____

Name of Organization Running Log _____

GEOLOGIC DATA (Office Use Only)

Surface Elev.	Geologic Unit	Unit Thickness	Depth to Top
Subs. SWL	Date	Analysis	Aquifer Test

Driller's Remarks

If more than one screen,
show location of each on sketch.