State Well Report For Office Use Only:						
County: Marshail Part 1-1						
Mississippi Departmer	nt of Environmental Quality	Aquifer:				
	and Water Resources	Well #: 6 - 43				
I DINICL AND CALLY VICE OF T	Box 10631					
	AS 39289-0631 961-5210	L. S. Elevation:				
	4-6938 (fax)	E-log #:				
State Law requires that this report be prepared by the license holder responsible for the work and filed with the Department at the above address within 30 days of completion of drilling of the well or borehole.						
	Information on Well Owner Well or Bo					
(Landowner if borehole is not for a water well)	Latitude: 34 • 51 ·351 " Longitude: 89 • 24 · 339 " Method of Lat/Long (circle one): Conventional Survey,					
Owner Name Joe Moury	21	20				
Mailing Address: 3782 Hwy 7	Method of Lat/Long (circle on	e): Conventional Survey,				
Maning Address. 370 & AGN	USGS quad, Hand-held GP9, Survey-grade GPS					
	NE 1/ 505 1/ Sec 4	<u> Twn つを Rng つい</u>				
Holly Springs MS 38635 City State Zip Code	I NE					
City State Zip Code	Distance Direction Miles NE	Nearest Town of Holly Springs				
Telephone No. (662) 252 - 1192	TYTIOS ,	31 (1314 Sp) 1-51				
Well / Bore	hole Data					
Date drilling started: 10-13-07 Date drilling completed: (0-13-07 Hole depth: 133' Hole diameter: 8"						
Location of the source of any surface water used for drilling: Method of dosing and volume of Chlorine used in drilling and development: Method of dosing and volume of Chlorine used in drilling and development:						
Logs run (circle all applicable) No log run Electric Gamma Ray Density Sonic Neutron Other:						
Purpose of borehole (check one): Water Well Geotechnical/Geological Investigation Ground Source Heat Pump						
Seismic SurveyOther (describe)						
If drilling is not related to water well construction, skip the remainder of this block						
Purpose of Well (check one): Home / Industrial Public Supply Irrigation Fish Culture Other:						
If a flowing well, method of flow regulation: ValveOther (describe)						
Static Water Level: 50 feet above or below (circle one) land surface Date measured: 10-13-07						
Method of Measurement (circle one) steel tape electric tape air line other: String (weight						
Well depth: 13' Well grouted to a depth of 10 feet Type of grout (circle one): Neat Cement Bentonite Mix						
Casing length: 113 feet Casing diameter: 4 inches Type of casing: poc						
Screen length: 10 feet Screen diameter: 4 inches Type of screen: pcc						
Screen slot size: Oto inches Setting depth: From 1/3 feet to 123 feet						
Type of completion (circle all applicable): Gravel packed Under	reamed Telescoped Open I	nole Natural Development				
Other (describe): جم کے						

Top of lap pipe or reduction in casing:

feet. If telescoped or more than one screen, describe on next page

Form: OLWR-SWR-1A




The sketch below only required for water wells

It	well	telesco	pes,	show	depths	on	sketch.
	Gr	ound Le	vel.				

Description of formations encountered must be provided for all wells and boreholes, unless specifically exempted by regulations

Description of Formations Encountered	From (depth)	To (depth)
Clay dirt	Ground Level	3 5
ertite sone	25	123
		1
		
	 	
	 	
	 	+
		-
· · · · · · · · · · · · · · · · · · ·	 	
		
	<u> </u>	
	 	<u> </u>
	 	
	ļ <u></u>	
	 	
L		

If more than one screen, show location of each on sketch

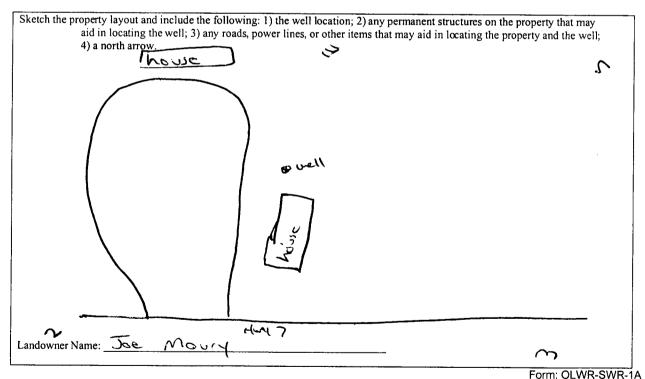

I certify that the well/borehole was drilled, constructed, and completed in accordance with all applicable requirements of the Mississippi Department of Environmental Quality and the Mississippi Department of Health regulations, if applicable, and state laws.

0-630 Dones W. Masa

Print Name of Responsible Licensee and License No.

STATE WELL REPORT Part 2 County: Morshall For Office Use Only: **Pump Installer's Completion Report** Permit #: Mississippi Department of Environmental Quality Aquifer: Office of Land and Water Resources Driller: Joses on Mason P.O. Box 10631 Jackson, MS 39289-0631 Date completed: 10-13-05 (601)961-5210 Elevation: (601)354-6938 (fax) Copy information from block on Part 1 This part of the report must be completed by a licensed water well contractor or a licensed pump installer. A copy of Part 1 of the report must be attached and both parts filed with the Department at the above address within 30 days of well completion. **Well Owner Information** Well Location Owner Name: Jee Mesry Latitude: 34.51.351 Longitude: 89. 24. 339 Mailing Address: 3787 Hun 7 Method of Lat/Long (check one): Conventional Survey, USGS quad____, Hand-held GPS___, Survey-grade GPS___ NE 1/ Sw 1/ Sec 4 T 25 R 2W Direction Nearest Town Miles NE of Holy Springs. Telephone No. (662) 252 1192 **Pump Type Power Type** Circle one Circle one Air Lift Jet Submersible Diesel Engine Gasoline Engine Natural Gas Bucket Piston Turbine Electric Motor Hand **Tractor PTO** Centrifugal Rotary Flowing Well Windmill Other (specify): Other (specify): Horse Power Rating of Motor: Date Pump Installed: 10-13-05 Setting Depth: ______ feet Rated Pump Capacity: Number of Stages: _____ [[Gallons Per Minute Pump Test Data Method of Measuring Water Level Circle one 10-13-05 Date Well Tested: Air Line Electric Measuring Line Static Water Level (A): 50 Feet Below Land Surface Other (specify): String / weigh Pumping Water Level (B): NA Feet Below Land Surface Drawdown [(B) - (A)]: \nearrow Feet Below Land Surface For flowing well, measured shut in head: Test Pumping Rate: Gallons Per Minute Well yielded GPM with a drawdown of

I HEREBY CERTIFY that the above statements are true to the best of my knowledge.

The sum of Pump Installer and License No. (if applicable)

Signature of Pump Installer

Duration of Pump Test (minimum 4 hours):

Form: OLWR-SWR-1B

ks y compared to

hours of pumping