

RECEIVED

MAY 09 2008

For Office Use Only:

BY: OLWR

County: Marshall
 Permit #: 0-162
 Driller: Lang Carpenter
 Date drilling completed: 4-22-08

State Well Report
Part 1 - Driller's Log
 Mississippi Department of Environmental Quality
 Office of Land and Water Resources
 P.O. Box 10631
 Jackson, MS 39289-0631
 (601)961-5210
 (601)354-6938 (fax)

Well #: G-120
 L. S. Elevation: _____
 E-log #: _____

State Law requires that this report be prepared by the license holder responsible for the work and filed with the Department at the above address within 30 days of completion of drilling of the well or borehole.

<p>Information on Well Owner (Landowner if borehole is not for a water well)</p> <p>Owner Name: <u>Southern Homez</u> Mailing Address: <u>P.O. Box 5172</u> <u>Holly Springs Ms 38634</u> City State Zip Code Telephone No. <u>(662) 252-3497</u></p>	<p>Well or Borehole Location</p> <p>Latitude: _____ Longitude: _____</p> <p>Method of Lat/Long (circle one): Conventional Survey, USGS quad, Hand-held GPS, Survey-grade GPS</p> <p>_____ 1/4 _____ 1/4 Sec <u>20</u> Twn <u>25</u> Rng <u>24</u></p> <p>Distance Direction Nearest Town <u>3 1/2</u> Miles <u>South</u> of <u>Sloyden</u></p>
---	--

Well / Borehole Data

Date drilling started: 4-22-08 Date drilling completed: 4-22-08 Hole depth: 180' Hole diameter: 8"

Location of the source of any surface water used for drilling: Well Water
 Method of dosing and volume of Chlorine used in drilling and development: 1/2 pt chlorine to 1000 gal water

Logs run (circle all applicable): No log run Electric Gamma Ray Density Sonic Neutron Other: _____
 Name of organization running log(s): _____

Purpose of borehole (check one): Water Well Geotechnical/Geological Investigation _____ Ground Source Heat Pump _____
 Seismic Survey _____ Other (describe) _____

If drilling is not related to water well construction, skip the remainder of this block

Purpose of Well (check one): Home Industrial _____ Public Supply _____ Irrigation _____ Fish Culture _____ Other: _____

If a flowing well, method of flow regulation: Valve _____ Other (describe) _____

Static Water Level: 120 feet above or below (circle one) land surface Date measured: 4-22-08

Method of Measurement (circle one) steel tape electric tape air line other: _____

Well depth: 180' Well grouted to a depth of 10 feet Type of grout (circle one): Neat Cement Bentonite Mix

Casing length: 170 feet Casing diameter: 4 inches Type of casing: PVC

Screen length: 10 feet Screen diameter: 4 inches Type of screen: PVC

Screen slot size: .013 inches Setting depth: From 170 feet to 180 feet

Type of completion (circle all applicable): Gravel packed Underreamed Telescoped Open hole Natural Development
 Other (describe): _____


Top of lap pipe or reduction in casing: _____ feet. *If telescoped or more than one screen, describe on next page*

The sketch below only required for water wells

Description of formations encountered must be provided for all wells and boreholes, unless specifically exempted by regulations

If well telescopes, show depths on sketch

Ground Level \rightarrow

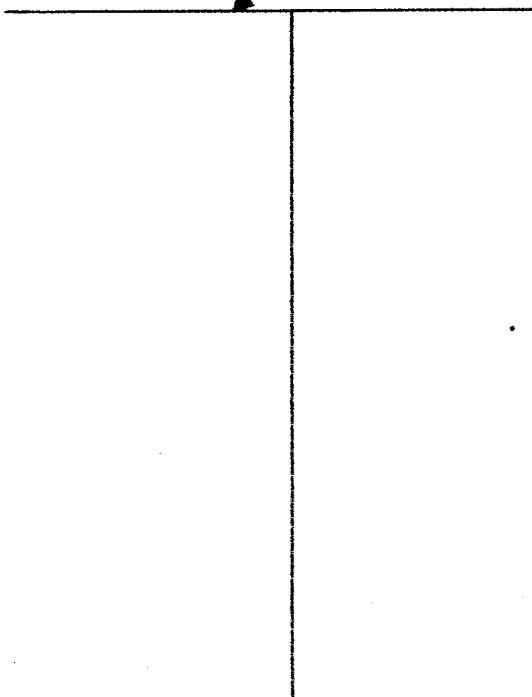

Description of Formations Encountered	From (depth)	To (depth)
Surface Soil	0	20
med. Red Sand	20	42
Med. White Sand	42	55
Rock	55	56
White clay	56	90
med. White Sand	90	145
White coarse Sand	145	180

If more than one screen, show location of each on sketch

Sketch the property layout and include the following: 1) the well location; 2) any permanent structures on the property that may aid in locating the well; 3) any roads, power lines, or other items that may aid in locating the property and the well; 4) a north arrow.

Property
House
Driveway
Well
Subd. Rd.
South Slayden Rd.
North \rightarrow

Landowner Name: Southern Homes

RECEIVED
MAY 09 2008
BY: OLWR

Form: OLWR-SWR-1A

I certify that the well/borehole was drilled, constructed, and completed in accordance with all applicable requirements of the Mississippi Department of Environmental Quality and the Mississippi Department of Health regulations, if applicable, and state laws.

LARRY CARPENTER 0-162 4-25-08 Larry Carpenter

Print Name of Responsible Licensee and License No. Date Signature of Licensee

RECEIVED

MAY 09 2008

STATE WELL REPORT

Part 2

Pump Installer's Completion Report
Mississippi Department of Environmental Quality
Office of Land and Water Resources
P.O. Box 10631
Jackson, MS 39289-0631
(601)961-5210
(601)354-6938 (fax)

BY: OLWR
For Office Use Only:

County: Marshall
Permit #: 0-162
Driller: Larry Carpenter
Date completed: 4-22-08
Copy information from block on Part 1

Aquifer:
Well #: G-120
Elevation:

This part of the report must be completed by a licensed water well contractor or a licensed pump installer. A copy of Part 1 of the report must be attached and both parts filed with the Department at the above address within 30 days of well completion.

Well Owner Information: Southern Homes
Mailing Address: P.O. Box 5172
Holly Springs, MS 38634
Telephone No. (662) 252-3497
Well Location:
Latitude: Longitude:
Method of Lat/Long: Conventional Survey
USGS quad: Hand-held GPS: Survey-grade GPS
Distance: Direction: Nearest Town: 3 1/2 Miles South of Sledge

Pump Type: Submersible
Power Type: Electric Motor
Air Lift: Jet
Bucket: Piston
Centrifugal: Rotary
Other (specify):
Date Pump Installed: 4-22-08
Rated Pump Capacity: 10 Gallons Per Minute
Diesel Engine: Gasoline Engine: Natural Gas
Electric Motor: Hand: Tractor PTO
Windmill: Other (specify):
Horse Power Rating of Motor: 3/4
Setting Depth: 140 feet
Number of Stages: 11

Pump Test Data:
Date Well Tested: 4-22-08
Static Water Level (A): 120 Feet Below Land Surface
Pumping Water Level (B): 125 Feet Below Land Surface
Drawdown [(B) - (A)]: 5 Feet Below Land Surface
Test Pumping Rate: 15 Gallons Per Minute
Duration of Pump Test (minimum 4 hours): 4 hours
Method of Measuring Water Level: Steel Tape
Air Line: Electric Measuring Line
Other (specify):
For flowing well, measured shut in head: feet
Well yielded 15 GPM with a drawdown of 5 feet after 4 hours of pumping

I HEREBY CERTIFY that the above statements are true to the best of my knowledge.

LARRY CARPENTER 0-162
Print Name of Pump Installer and License No. (if applicable)

Larry Carpenter
Signature of Pump Installer