

STATE WELL REPORT

Part I

Driller's Log

Mississippi Department of Environmental Quality
Office of Land and Water Resources
P.O. Box 2309
Jackson, MS 39225-2309
(601)961-5210
(601)360-0535 (fax)

For Office Use Only:

Well #: Q G 143
Aquifer: _____
E-Log #: _____

County: Marshall
Permit #: 0162
Driller: Larry Carpenter
Date drilling completed: 11-14-14

State Law requires that this report be prepared by the license holder responsible for the work and filed with the Department at the above address within 30 days of completion of drilling of the well or borehole.

Well Owner Information (Landowner if borehole is not for a water well) Owner Name: <u>Scott Seals</u> Mailing Address: <u>115 South Shyden Rd</u> <u>Holly Spring MS 38635</u> City State Zip Code Telephone No. (901) <u>857-3415</u>		Well or Borehole Location Latitude: <u>34° 51' 41" N</u> Longitude: <u>89° 24' 51" W</u> Method of Lat/Long (check one): Conventional Survey _____, USGS quad _____, Hand-held GPS <u>X</u> , Survey-grade GPS _____ <u>SE</u> 1/4 <u>SE</u> 1/4, Sec <u>34</u> T <u>25</u> R <u>2W</u> <u>2</u> Miles <u>W</u> of <u>Hudsonville</u> (Distance) (Direction) (Nearest Town)
---	--	---

Well / Borehole Data

Date drilling started: 11-14-14 Date drilling completed: 11-14-14 Hole depth: 145' Hole diameter: 8"
Location of the source of any surface water used for drilling: Well Water
Method of dosing and volume of Chlorine used in drilling and development: 1/2 pt. Chlorine to 1000 Gal. Water
Logs run (circle all applicable): No log run Electric Gamma Ray Density Sonic Neutron Other: _____
Name of organization running log(s): _____
Purpose of borehole (circle one): Water Well Geotechnical/Geological Investigation Ground Source Heat Pump
Seismic Survey Other (describe) _____

If drilling is not related to water well construction, skip the remainder of this block

Purpose of Well (circle all applicable): Home Industrial Public Supply Irrigation Fish Culture
Other (describe): _____
If a flowing well, method of flow regulation: Valve _____ Other (describe) _____
Static Water Level: 70 feet (above or below land surface) (circle one) Date measured: 11-14-14
Method of measurement (circle one): Steel tape Electric tape Air line Other (describe): _____
Well depth: 145' Well grouted to a depth of: 10 feet Type of grout (circle one): Neat Cement Bentonite Mix
Casing length: 135 feet Casing diameter: 4 inches Type of casing: PVC
Screen length: 10 feet Screen diameter: 4 inches Type of screen: PVC
Screen slot size: .013 inches Setting depth: From 135 feet to 145 feet
Type of completion (circle all applicable): Gravel packed Underreamed Open hole Natural Development
Other (describe): _____
Top of lap pipe or reduction in casing: _____ feet

If telescoped or more than one screen, describe on next page

RECEIVED

DEC 10 2014

Form: OLWR-SWR-1A (4/13)

BY OLWR

For Office Use Only:
Well #: G143

If well telescopes, show depths on sketch.

Ground Level


Description of formations encountered must be provided for all wells and boreholes, unless specifically exempted by regulations

[illegible]

If more than one screen, show location of each on sketch

Sketch the property layout and include the following:

- 1) the well location
- 2) any permanent structures on the property that may aid in locating the well
- 3) any roads, power lines, or other items that may aid in locating the property and the well
- 4) north arrow

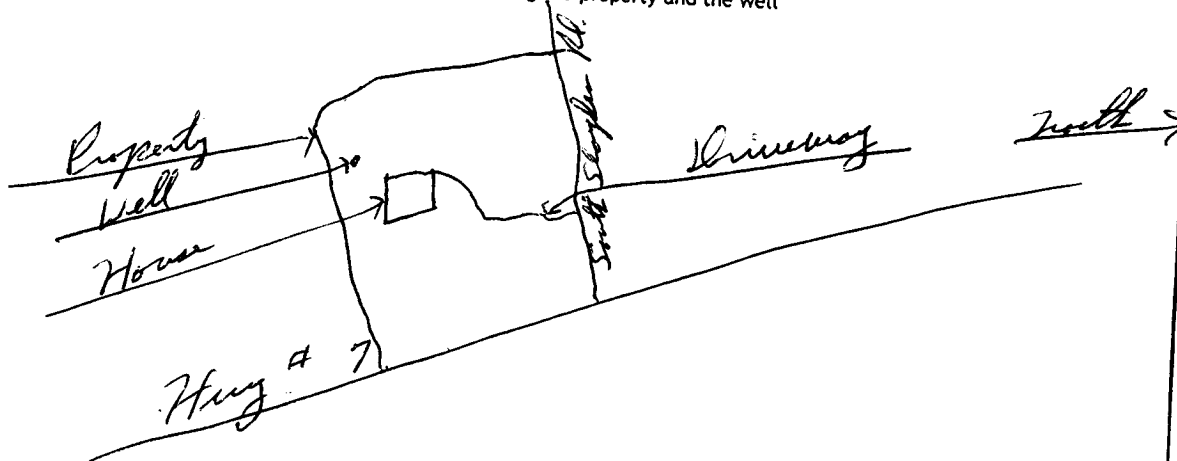

Landowner Name: Scott Seals

I HEREBY CERTIFY that the well/borehole was drilled, constructed, and completed in accordance with all applicable requirements of the Mississippi Department of Environmental Quality and the Mississippi Department of Health regulations, if applicable, and state laws.

Larry Carpenter #0162
 Print Name of Responsible Licensee and License No.

11-16-14
 Date

Larry Carpenter
 Signature of Licensee

Form: OLWR-SWR-1A (4/13)

RECEIVED

DEC 10 2014

(4/13) OLIVER

STATE WELL REPORT

Part 2

Pump Installer's Completion Report
Mississippi Department of Environmental Quality
Office of Land and Water Resources
P.O. Box 2309
Jackson, MS 39225-2309
(601)961-5210
(601) 360-0535 (fax)

For Office Use Only:

Well #: 0143

Aquifer: _____

County: Marshall
Permit #: 0162
Driller: Larry Carpenter
Date completed: 11-15-14
Copy information from block on Part 1

This part of the report must be completed by a licensed water well contractor or a licensed pump installer. A copy of Part 1 of the report must be attached and both parts filed with the Department at the above address within 30 days of well completion.

Well Owner Information		Well Location	
Owner Name: <u>Scott Seals</u>		Latitude: <u>34° 51' 41"</u> Longitude: <u>89° 24' 07.5"</u>	
Mailing Address: <u>115 South Slayden Rd</u>		Method of Lat/Long (check one): Conventional Survey _____, Hand-held GPS <u>X</u> , Survey-grade GPS _____	
City: <u>Holly Springs</u>	State: <u>MS</u>	USGS quad: <u>SE 1/4 SE 1/4, Sec 34 T 25 R 2W</u>	
Zip Code: <u>38635</u>	Telephone No. <u>(901) 857-3415</u>		
		<u>2</u> Miles <u>W</u> of <u>Hudsonville</u> (Distance) (Direction) (Nearest Town)	

Pump Type (circle one)
Submersible Turbine Air Lift Centrifugal Flowing Well Jet Piston Rotary Other (describe): _____

Date Pump Installed: 11-15-14 Rated Pump Capacity: 18 Gallons Per Minute

Is This Pump (circle one): New Repaired Replacement

Power Type (circle one)
Electric Diesel Gasoline Natural Gas Tractor PTO Windmill Other (describe): _____

Horse Power Rating of Motor: 1/2 Setting Depth: 100 feet Number of Stages: 12

Pump Test Data for Non Flowing Well

Date Well Tested: 11-15-14 Duration of Pump Test (minimum 4 hours): 4 hours

Static Water Level (A): 70 Feet Below Land Surface Pumping Water Level (B): 76 Feet Below Land Surface

Drawdown [(B) - (A)]: 6 Feet Below Land Surface Test Pumping Rate: 20 Gallons Per Minute

Method of measurement (circle one): Steel tape Electric tape Air line Other (describe): _____

Pump Test Data for Flowing Well

Measured shut in head: _____ feet.

Well yielded _____ GPM with a drawdown of _____ feet after _____ hours of pumping

Meter Installation

Meter Manufacturer: _____ Meter Serial Number: _____

Meter Model Number/Name: _____ Type of Meter: _____

Totalizer Register Unit and Multiplier Factor (AF x .001, gal x 1000, etc): _____

Installation Date: _____ Meter installed by: _____

Is This Meter (circle one): New Repaired Replacement

Important: By submitting the above information you are certifying that this meter was installed to manufacturer standards. For agricultural wells, a list of approved meters is on the MDEQ website.

I HEREBY CERTIFY that the above statements are true to the best of my knowledge.

Larry Carpenter #0162 11-16-14 Larry Carpenter
Print Name of Pump Installer and License No. (if applicable) Date Signature of Pump Installer

Form: OLWR-SWR-1B (4/13)

RECEIVED

DEC 10 2014

BY OLWR