

Marshall
G 2000
10-22-75

**MISSISSIPPI
BOARD OF WATER COMMISSIONERS**
416 North State Street
Jackson, Mississippi 39201

WATER WELL DRILLERS LOG

OCT 27 1975 Billy R. Simpson MARSHALL
date well completed firm name county well located

LANDOWNER:
RICHARD BOONE
Holly Springs, MS.
(mailing address)

description of formations encountered	from	to
<u>SAND</u>	<u>0</u>	<u>10</u>
<u>RED CLAY</u>	<u>10</u>	<u>18</u>
<u>WHITE CLAY & SAND</u>	<u>18</u>	<u>105</u>
<u>COARSE SAND</u>	<u>105</u>	<u>133</u>

WELL LOCATION:
sec 35 T 2 N R 2 E
S W
0 miles of HUDSONVILLE
(distance) (direction) (nearest town)

WELL PURPOSE: HOUSE
(home, irrigation, municipal, industrial)

- WELL COMPLETION DATA:**
- (1) diameter (inches) 4
 - (2) total depth (feet) 133
 - (3) static water level (feet) 60 below top of ground.
 - (4) casing POC 127
(material) (depth)
If telescope see back. (size)
 - (5) screen 6' 127
(length) (depth to top)
4" POC
(size) (material)
 - (6) pump 1/2 7
(HP) (yield gpm)
Elec
(type power)
 - (7) electric log No
(yes or no)


(organization running log)
 - (8) how well bottom plugged POC
CLAY

DRILLERS REMARKS:

RECEIVED
JAN 26 1976

If well telescopes please sketch and show depths.

GROUND LEVEL

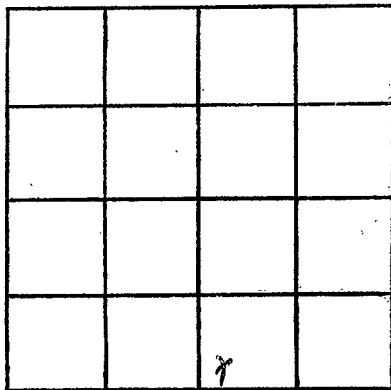

SECTION 35

Please indicate well location X.

ADDITIONAL INFORMATION

If more than one screen,
show locations of each on sketch.