

MARSHALL

G 2001

11-7-75

MISSISSIPPI BOARD OF WATER COMMISSIONERS
416 North State Street
Jackson, Mississippi 39201

WATER WELL DRILLERS LOG

Nov 7 1975
date well completed

16N R. L. Carpenter
firm name

Marshall
county well located

LANDOWNER: Burt Shetter
Lena, Miss

description of formations encountered

from to

Surface Soil 0 10

Med. Brown Soil 10 25

Med. White Sand 25 40

White Clay 40 47

White Coarse Sand 47 78

R.F.D.
(mailing address)

WELL LOCATION:

sec. 3 T. 2 N. R. 2 E.
2 1/2 miles East of Shyles
(distance) (direction) (nearest town)

WELL PURPOSE: Home
(home, irrigation, municipal, industrial)

WELL COMPLETION DATA:

- (1) diameter (inches) 4
- (2) total depth (feet) 78
- (3) static water level (feet) 36 below above top of ground.
- (4) casing Plastic, 68 ft.
(material) (depth)

(size) if telescope see back.

- (5) screen 10, 68 ft.
(length) (depth to top)
- 1/2", Plastic
(size) (material)


- (6) pump 3/4, 1.0
(HP) (yield gpm)
- Elec
(type power)

- (7) electric log No.
(yes or no)

(organization running log)

- (8) how well bottom plugged Plastic Cap

DRILLERS REMARKS:

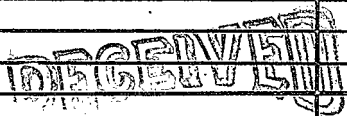


MAR 2 1975

OF WATER COMMISSIONERS

If well telescopes please sketch and show depths.

GROUND LEVEL

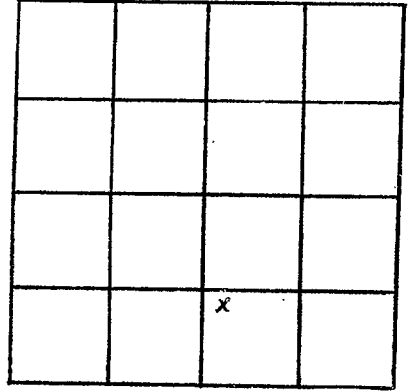

SECTION 3

Please indicate well location X.

ADDITIONAL INFORMATION

If more than one screen,
show locations of each on sketch.