

Marshall
G 2004
1-13-77

MISSISSIPPI
BOARD OF WATER COMMISSIONERS
416 North State Street
Jackson, Mississippi 39201

WATER WELL DRILLERS LOG

Jan. 13 1977 R. L. Carpenter Marshall
date well completed firm name county well located

LANDOWNER: David Briggs
Hudsonville, Miss.
RFD
(mailing address)

WELL LOCATION:
sec. 33 T 2 N R 2 E
West of Hudsonville
3 miles (distance) (direction) (nearest town)

WELL PURPOSE: Drain
(home, irrigation, municipal, industrial)

- WELL COMPLETION DATA:
- (1) diameter (inches) 4
 - (2) total depth (feet) 150
 - (3) static water level (feet) 80 below above top of ground.
 - (4) casing Plastic, 144 ft.
(material) (depth)
 if telescope see back.
(size)
 - (5) screen 6', 144'
(length) (depth to top)
4", Plastic & Thrawl
(size) (material)
 - (6) pump 3/4 10
(HP) (yield gpm)
Flas
(type power)
 - (7) electric log no
(yes or no)

(organization running log)
 - (8) how well bottom plugged Plastic Cap

description of formations encountered	from	to
Surface Soil	0	18
med. Red Sand	18	46
Coarse white sand	46	70
white clay	70	84
white coarse sand	84	150


DRILLERS REMARKS:

RECEIVED
FEB 10 1977

MISS. BD. OF WATER COMMISSIONERS

If well telescopes please sketch and show depths.

GROUND LEVEL

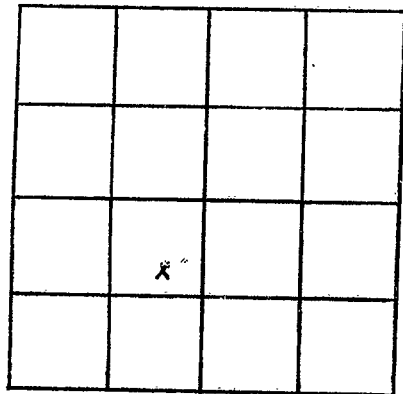

SECTION 33

Please indicate well location X.

ADDITIONAL INFORMATION

If more than one screen, show locations of each on sketch.