

**MISSISSIPPI
BOARD OF WATER COMMISSIONERS**
416 North State Street
Jackson, Mississippi 39201

WATER WELL DRILLERS LOG

Marshall
B 206
10/3/77

10-3 19 TD Pump & Drilling well Marshall
date well completed firm name county well located

LANDOWNER:

Lewis Clark
Holly Springs man
(mailing address)

description of formations encountered

clay
sand

from to

0 20
20 160

WELL LOCATION:

sec. 26 T. 2 N. R. 2 E.
3 miles South of Jacksonville
(distance) (direction) (nearest town)

WELL PURPOSE: Drainage
(home, irrigation, municipal, industrial)

WELL COMPLETION DATA:

- (1) diameter (inches) 4"
- (2) total depth (feet) 160 feet
- (3) static water level (feet) 85 below above top of ground.
- (4) casing Pvc 160 feet
(material) (depth)
 if telescope see back.
(size)
- (5) screen 24" 153 feet
(length) (depth to top)
4" gravel
(size) (material)
- (6) pump 3/4 14
(HP) (yield gpm)

(type power)
- (7) electric log elect.
(yes or no)

(organization running log)
- (8) how well bottom plugged 4' cgl.


DRILLERS REMARKS:

RECEIVED
NOV - 4 1977

MISS. BD. OF WATER COMMISSIONERS

If well telescopes please sketch and show depths.

GROUND LEVEL

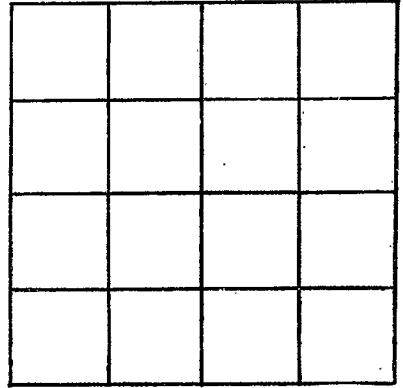

SECTION _____

Please indicate well location X.

ADDITIONAL INFORMATION

If more than one screen, show locations of each on sketch.