

MARSHALL

G 2007

12-15-77

MISSISSIPPI BOARD OF WATER COMMISSIONERS  
416 North State Street  
Jackson, Mississippi 39201

WATER WELL DRILLERS LOG

DEC 15

1977

Billy R Simpson

MARSHALL

date well completed

firm name

county well located

LANDOWNER:	description of formations encountered	from	to
SAVANNAH JENKINS			
Billy SPRINGS MS (mailing address)	SAND & WHITE CLAY	15'	130'
WELL LOCATION:	COARSE SAND	130'	154'
sec. <u>36</u> T. <u>2</u> N. R. <u>2</u> E	FINE SAND	154'	174'
<u>8</u> miles <u>N</u> of <u>Billy SPGS</u>	MED. SAND	174'	185'
(distance) (direction) (nearest town)			
WELL PURPOSE: (home, irrigation, municipal, industrial)			
WELL COMPLETION DATA:			
(1) diameter (inches) <u>4</u>			
(2) total depth (feet) <u>185</u>			
(3) static water level (feet) <u>96</u> below top of ground.			
(4) casing <u>pvc 179</u> (material) (depth)			
(size) if telescope see back.			
(5) screen <u>6'</u> <u>179</u> (length) (depth to top)			
<u>4"</u> <u>pvc</u> (size) (material)			
(6) pump <u>3/4</u> <u>10</u> (HP) (yield gpm)			
<u>FLCC</u> (type power)			
(7) electric log <u>NS</u> (yes or no)			
(organization running log)			
(8) how well bottom plugged <u>pvc</u> <u>CAP</u>			
DRILLERS REMARKS:			


RECEIVED

APR 24 1978

MISS. BD. OF WATER COMMISSIONERS

If well telescopes please sketch and show depths.

GROUND LEVEL

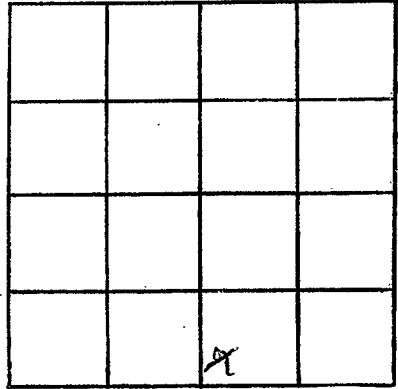

SECTION 36

Please indicate well location X.

ADDITIONAL INFORMATION

If more than one screen,  
show locations of each on sketch.